

CODED

Pontotoc
D-43
9-67

MISSISSIPPI
BOARD OF WATER COMMISSIONERS
416 North State Street
Jackson, Mississippi 39201

CODED

WATER WELL DRILLERS LOG

9-9-67 1967 Lamar Willer Pontotoc
date well completed firm name county well located

LANDOWNER:

A. L. WISEMAN

description of formations encountered

from to

RT-1-BELDEN, MISS
(mailing address)

Red CLAY SAND 0 100
BLUE SHALE 100 300
GREYISH SHALE 300 400
Rock SAND 400 462
BLUE SHALE 462 462

WELL LOCATION:

sec. 3 T. 9 S. R. 4 E
3 miles SW of SAERMAN
(distance) (direction) (nearest town)

WELL PURPOSE: Home
(home, irrigation, municipal, industrial)

WELL COMPLETION DATA:

- (1) diameter (inches) 4
- (2) total depth (feet) 462
- (3) static water level (feet) 168 below top of ground.
- (4) casing STEEL, 123 (material), (depth)

(size) If telescope see back.

- (5) screen (length) (depth to top)

(size) (material)

- (6) pump 3/4 700 GPH (HP) (yield gpm)

ELECTRIC
(type power)


- (7) electric log NO (yes or no)

(organization running log)

- (8) how well bottom plugged


DRILLERS REMARKS:

CODED

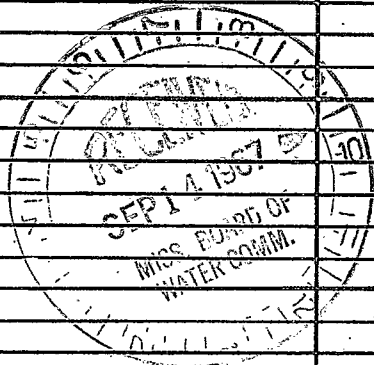

If well telescopes please sketch and show depths.

GROUND LEVEL

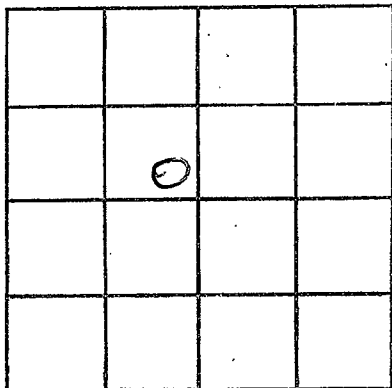

SECTION 3

Please indicate well location X.

ADDITIONAL INFORMATION

If more than one screen,
show locations of each on sketch.