

PONTOTOC
 D-47
 8-31-71

MISSISSIPPI
 BOARD OF WATER COMMISSIONERS
 416 North State Street
 Jackson, Mississippi 39201

WATER WELL DRILLERS LOG

Aug 31 1971 J.W. Wilkerson Pontotoc
 date well completed firm name county well located

CODED

LANDOWNER: Calvin Coakley	description of formations encountered	from	to
Belden Miss (mailing address)	Soil	0	1
WELL LOCATION: sec. 10 T. 95 N R. 4 E S W 1 1/4 miles Post of Ennis (distance) (direction) (nearest town)	Bunko	1	31
WELL PURPOSE: (home, irrigation, municipal, industrial)	Blue Rock	31	301
WELL COMPLETION DATA:	Water Rock	301	302
(1) diameter (inches) 5"	Water sand	307	425
(2) total depth (feet) 425'	Coffee sand		
(3) static water level (feet) 135' below top of ground.			
(4) casing steel 42' (material) (depth) 5" (size) If telescope see back.			
(5) screen 0 (length) (depth to top)			
(6) pump 1/2 HP sub 8 (HP) (yield gpm) Elec (type power)			
(7) electric log (yes or no)			
(organization running log)			
(8) how well bottom plugged			
DRILLERS REMARKS:			


CODED

SEP 10 1971

MISS. BD. OF
 WATER COMM.

If well telescopes please sketch and show depths.

GROUND LEVEL

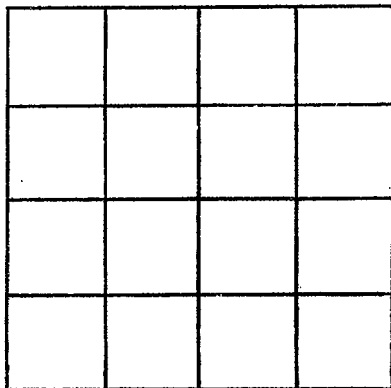

SECTION _____

Please indicate well location X.

ADDITIONAL INFORMATION

If more than one screen,
show locations of each on sketch.