

MISSISSIPPI
BOARD OF WATER COMMISSIONERS
416 North State Street
Jackson, Mississippi 39201

CODED

PONTOTOC
D-48
9-11-71

WATER WELL DRILLERS LOG

Sept 11 1971 Ed Clark Con. Pontotoc
date well completed firm name county well located

LANDOWNER:

Sam Caldwell
Sherman Rt.
(mailing address)

description of formations encountered

from to

| | | |
|------------------------------------|------------|------------|
| <u>Red clay</u> | <u>0</u> | <u>40</u> |
| <u>Rock & Sand</u> | <u>40</u> | <u>160</u> |
| <u>Blue mud</u> | <u>160</u> | <u>400</u> |
| <u>Rock & Sand & water</u> | <u>400</u> | <u>500</u> |

WELL LOCATION:

sec. 1 T. 9 N. R. 4 E.
S. W.
4 miles S of Sherman
(distance) (direction) (nearest town)

WELL PURPOSE: None
(home, irrigation, municipal, industrial)

WELL COMPLETION DATA:

- (1) diameter (inches) 4"
- (2) total depth (feet) 500'
- (3) static water level (feet) 110' below top of ground.
- (4) casing Metal, 126'
(material) (depth)
4" if telescope see back.
(size)
- (5) screen none
(length) (depth to top)
(size) (material)
- (6) pump no
(HP) (yield gpm)
Electric
(type power)
- (7) electric log no
(yes or no)
(organization running log)
- (8) how well bottom plugged no

CODED


SEP 16 1971

MISS. DL.
ENGINEER
REGISTERED

DRILLERS REMARKS:

If well telescopes please sketch and show depths.

GROUND LEVEL

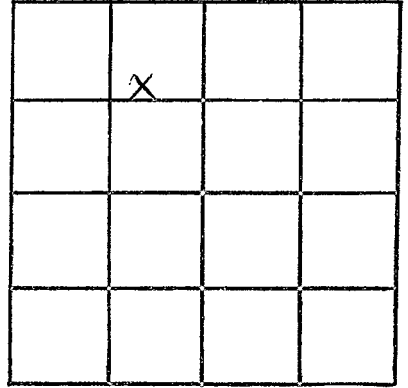

SECTION _____

Please indicate well location X.

ADDITIONAL INFORMATION

If more than one screen,
show locations of each on sketch.