

**PONTOTOC**  
**D 52**  
**5-30-72**

MISSISSIPPI  
 BOARD OF WATER COMMISSIONERS  
 416 North State Street  
 Jackson, Mississippi 39201

WATER WELL DRILLERS LOG


5-30-1972 date well completed  
 Leeper Drilling Co. firm name  
 Pontotoc county well located

LANDOWNER:	description of formations encountered	from	to
W. R. Holden		Red Clay & Rock	0
RT1 Belden, Miss - (mailing address)	Blue Clay	50	80
	Blue Clay I	80	200
	Blue Clay & Chalk	200	350
	Chalk & Sand -	350	490
<b>WELL LOCATION:</b>			
sec. <u>3</u> T. <u>9</u> N. R. <u>4</u> E			
<u>4</u> miles <u>SW</u> of <u>Sherman</u> (distance) (direction) (nearest town)			
<b>WELL PURPOSE:</b> <u>Home</u> (home, irrigation, municipal, industrial)			
<b>WELL COMPLETION DATA:</b>			
(1) diameter (inches)	<u>4</u>		
(2) total depth (feet)	<u>490</u>		
(3) static water level (feet)	<u>80</u> below top of ground.		
(4) casing (material)	<u>Steel</u>		
	(depth)	<u>84</u>	
	(size)	If telescope see back.	
(5) screen (length)	<u>open</u>		
	(depth to top)		
	(size)		
(6) pump (HP)	<u>1/2</u>		
	(yield gpm)	<u>7</u>	
	(type power)	<u>Elect</u>	
(7) electric log (yes or no)	<u>no</u>		
	(organization running log)		
(8) how well bottom plugged	<u>open</u>		
<b>DRILLERS REMARKS:</b>			

SEP 10 1972  
 JUL 12 1972

If well telescopes please sketch and show depths.

GROUND LEVEL

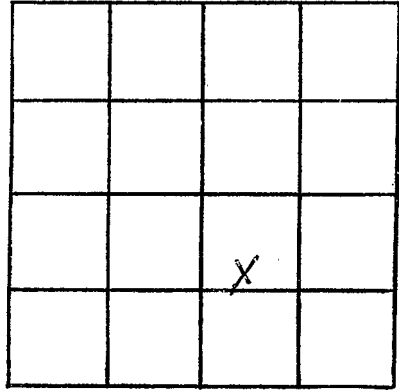

SECTION 3

Please indicate well location X.

ADDITIONAL INFORMATION

If more than one screen,  
show locations of each on sketch.