

MISSISSIPPI
 BOARD OF WATER COMMISSIONERS
 416 North State Street
 Jackson, Mississippi 39201

CODED

WATER WELL DRILLERS LOG

PONTOTOC
 D53
 10-1-71

10-1-71 date well completed Ed Clark firm name Pontotoc county well located

LANDOWNER:

Sam Casdwell

description of formations encountered

from

to

Pontotoc Rt 1
 (mailing address)

WELL LOCATION:

sec. 2 T 9 S R 4 E W
 4 miles SW. of Slomona
 (distance) (direction) (nearest town)

WELL PURPOSE: Home
 (home, irrigation, municipal, industrial)

WELL COMPLETION DATA:

- (1) diameter (inches) 4"
- (2) total depth (feet) 552'
- (3) static water level (feet) 80' below top of ground.
- (4) casing Metal, 126'
 (material) (depth)
 4 (size) if telescope see back.
- (5) screen None
 (length) (depth to top)
 (size) (material)
- (6) pump no no
 (HP) (yield gpm)
 (type power)
- (7) electric log no
 (yes or no)
 (organization running log)
- (8) how well bottom plugged no

CODED


SEP 20 1972

MISS. DD. 05
 WATER CODED

DRILLERS REMARKS:

If well telescopes please sketch and show depths.

GROUND LEVEL

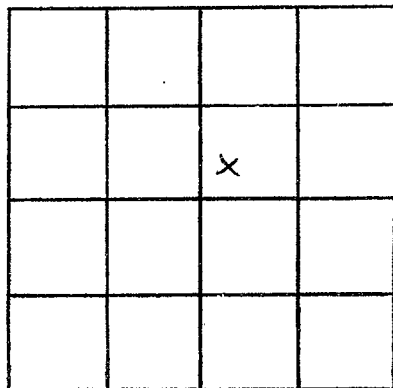

SECTION _____

Please indicate well location X.

ADDITIONAL INFORMATION

If more than one screen,
show locations of each on sketch.