

PONTOTOC
D 57
9-8-68

MISSISSIPPI
BOARD OF WATER COMMISSIONERS
416 North State Street
Jackson, Mississippi 39201

CODED

WATER WELL DRILLERS LOG

9-8-68 19 Ewing Yawes firm name Pontotoc county well located

LANDOWNER: Ray C. Dyer

description of formations encountered	from	to
<u>Coastal clay</u>	<u>0</u>	<u>30</u>
<u>Blue</u>	<u>30</u>	<u>20</u>
<u>Sandstone</u>	<u>250</u>	<u>450</u>
<u>Sand</u>	<u>1150</u>	<u>611</u>

Belden Dr 1
(mailing address)

WELL LOCATION:
sec. 21 T. 9 N. R. 4 E.
1/4 miles Southeast of Somerville
(distance) (direction) (nearest town)

WELL PURPOSE:
(home, irrigation, municipal, industrial)

- WELL COMPLETION DATA:
- (1) diameter (inches) 4
 - (2) total depth (feet) 611
 - (3) static water level (feet) 180 below above top of ground.
 - (4) casing CT 51
(material) (depth)
If telescope see back.
(size)
 - (5) screen 0
(length) (depth to top)
(size) (material)
 - (6) pump 3/11 250
(HP) (yield gpm)
FP220
(type power)
 - (7) electric log
(yes or no)
(organization running log)
 - (8) how well bottom plugged

CODED


REC 10 1968

MISS. BD. OF
WATER COMM.

DRILLERS REMARKS:

If well telescopes please sketch and show depths.

GROUND LEVEL

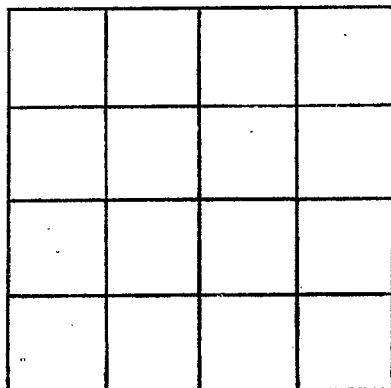

SECTION _____

Please indicate well location X.

ADDITIONAL INFORMATION

If more than one screen, show locations of each on sketch.