

PONTOTOC
D55

Elwg #40

2/79

MISSISSIPPI **CODED**
BOARD OF WATER COMMISSIONERS
416 North State Street
Jackson, Mississippi 39201

WATER WELL DRILLERS LOG

date well completed

19

firm name

county well located

T.M. PARKS DRIG

Pontotoc

LANDOWNER:

City of

description of formations encountered

from

to

Sherman,

Clay + Sand

0 16'

Sherman Miss.

Blue Clay + Chalk

16 219'

(mailing address)

Tight Sand + Clay

219 294'

WELL LOCATION:

sec. 25 T 8 N R 4 E
S W

Sand

294 405'

(distance) miles (direction) of (nearest town)

Clays + Shales

405 554'

WELL PURPOSE:

(home, irrigation, municipal, industrial)

Sandy fines

554 590'

WELL COMPLETION DATA:

Clays + Shale

590 625'

Sands + Shales

625 780'

fine gravel, red gravel

780 827'

TV

827'

(1) diameter (inches)

12 3/4

(2) total depth (feet)

827

(3) static water level (feet) ~~16'~~ below above top of ground.

16'

(4) casing (material)

12 3/4 680'

(size) if telescope see back.

(5) screen (length) (depth to top)

80' 695'

8" Stainless

(6) pump (HP) (yield/gpm)

50 300 gpm

3P (type power)

(7) electric log (yes or no)

Yes


(organization running log)

M.S.

(8) how well bottom plugged

BPV

CODED

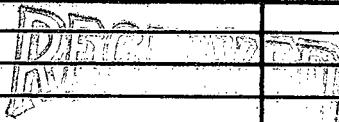

FEB 25 1979


MISS. BD. OF WATER

DRILLERS REMARKS:

④

If well telescopes please sketch and show depths.

GROUND LEVEL

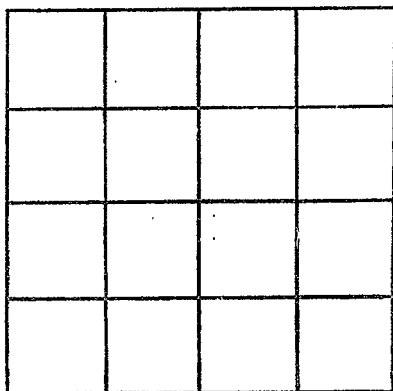

SECTION _____

Please indicate well location X.

ADDITIONAL INFORMATION

If more than one screen, show locations of each on sketch.