

PONTOTOC
 D56
 3-17-78
 Log # 48

MISSISSIPPI
 BOARD OF WATER COMMISSIONERS
 416 North State Street
 Jackson, Mississippi 39201

CODED

WATER WELL DRILLERS LOG

3/17 19 78 Layne-Central Company Pontotoc
 date well completed firm name county well located

LANDOWNER: Town of Sherman

Sherman, MS 38869
 (mailing address)

WELL LOCATION:

sec. 26 T 8 N R 4 E
 S W
 (distance) miles (direction) of (nearest town)

WELL PURPOSE:
 (home, irrigation, municipal, industrial)


WELL COMPLETION DATA:

- (1) diameter (inches) 20"
- (2) total depth (feet) 859'
- (3) static water level (feet) 188' below top of ground.
- (4) casing steel 769' (material) (depth)
 10" (size) If telescope see back.
 10'-779-789
- (5) screen 56' 46'-809-854 (length) (depth to top)
 6" stainless steel (size) (material)
- (6) pump 60 250 g.p.m. (HP) (yield gpm).
 elec. (type power)
- (7) electric log Yes. (yes or no)
 Miss. Geological Survey (organization running log)
- (8) how well bottom plugged 5' back pressure valve.

description of formations encountered

from to

Red Clay	0	15
Tough blue clay	15	277
Rock	277	278
Med. fine sand	278	329
Rock	329	330
Med. fine sand & clay	330	352
Clay	352	359
Med. fine sand & sandy clay	359	382
Tough blue clay	382	436
Sandy Clay	436	450
Tough clay	450	468
Hard sandy shell	468	528
Rock	528	529
Clay	529	594
Hard sandy shell	594	680
Fine sand & sandy shell	680	784
Sandy shale	784	804
Sand rock & clay	804	849
Hard Clay	849	866

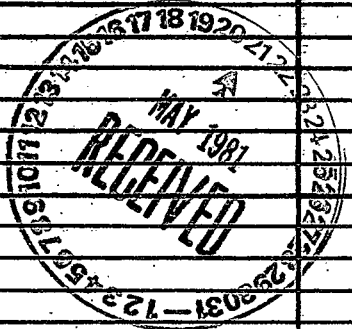

DRILLERS REMARKS:

(7)

If well telescopes please sketch and show depths.

GROUND LEVEL

SECTION _____

Please indicate well location X.

ADDITIONAL INFORMATION

If more than one screen, show locations of each on sketch.