
· E	State V	Vell Report		
		Part 1	For Office Use Only:	
	Permit #: Mississippi Department of Environmental Quality Ad		Aquifer:	
	Unice of Land	and Water Resources Box 10631	Well #:	
	Jackson N	MS 39289-0631	L. S. Elevation:	
	Date drilling completed: $\frac{\mu_{4}}{3} \frac{3}{6} \frac{601}{6}$	)961-5210	L. S. Elevation:	
		i4-6938 (fax)	E-log #:	
	State Law requires that this report be prepared by the 30 days of completion of drilling of the well.	e driller in detail and filed w	ith the Department within	
	Well Owner Information	Well	Location	
	Owner Name_Mark Nichola		_" Longitude:°'	
	Mailing Address: 118 Rubins Struct	Method of Lat/Long (circle or		
	The fals MIS 38#01		GPS, Survey-grade GPS	
	City State Zip Code	<sup>14</sup> <sup>14</sup> SecS	Twn S Rng 4E	
	Telephone No. (62) 541-2196	Distance Direction	of END UILL	
	Well ]	Well Data Dose of Well (circle one) Home Industrial Public Supply Irrigation Fish Culture Other:		
	Purpose of Well (circle one) Home Industrial Public Supply			
	Date well drilling started: $5 - 28 - 06$ Date well drilling completed: $449 - 31 - 06$ If flowing, method of flow regulation: Valve Other (describe)			
	Static Water Level:feet above of below (circle one) 1	and surface Date measured.	Section	
	Method of Measurement (circle one) steel tape electric tape			
	Hole depth: Well depth:	oth: Well depth: Well grouted to a depth of feet		
	Type of grout (circle one): Cement Bentonite Mix Casing length: <u>440</u> feet Casing diameter: <u>4</u> inches Type of casing: <u>JUC</u>			
	Screen length: <u>40</u> feet Screen diameter: <u>4</u> "			
	Screen slot size: <u>, , / o</u> inches Setting depth: From	440 feet to 48	Ufeet	
	Type of completion (circle all applicable): Gravel packed Underry			
	Other (describe):			
• • • • •	Top of lap pipe or reduction in casing:feet. If tel			
		ogs run (circle all applicable): No log run Electric Gamma Ray Density Sonic Neutron Other:		
	Name of organization running log(s):			
	I certify that the well was drilled, constructed, and completed in ac	ccordance with all applicable r	equirements of the Mississippi	
	Department of Environmental Quality and/or the Mississippi Depa	artment of Health regulations a	nd state laws	
	Leeper Drilling # 0079		Ceep .	
	Print Name of Water Well Contractor and License No.	Signature of V		
			SEP 28 2006	
			BY: OLWF	

r

If well telescopes please sketch below and show depths.

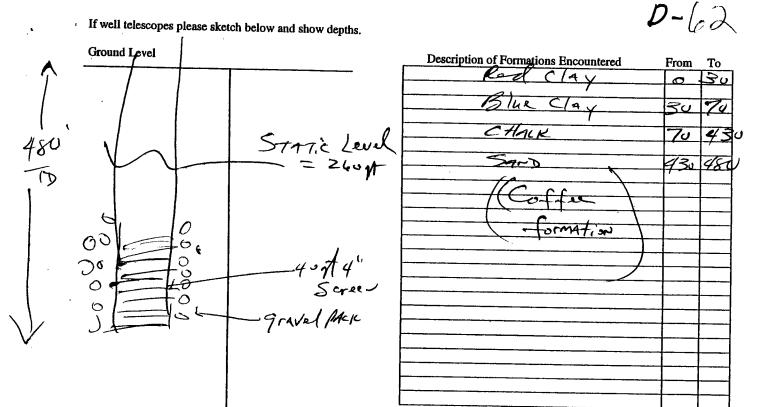

If more than one screen, show location of each on sketch

Sketch the property layout and include the following: 1) the well location; 2) any permanent structures on the property that may aid in locating the well; 3) any roads, power lines, or other items that may aid in locating the property and the well; 4) indicate direction. The wall HUME Nichols MARK Landowner Name: Signature of Water Well Contractor RECEIVED SEP 28 2006

BY: OLWR

County: Tan-to-toc	Part 2 Pump Installer's Completion Report Mississippi Department of Environmental Quali	For Office Use Only:	
Permit #:	Office of Land and Water Resources	ty Aquifer:	
Driller: Leeper Drilling	P.O. Box 10631 Jackson, MS 39289-0631	Well #: D- (02	
Date completed: $9 - (-0)$	(601)961-5210		
	(601)354-6938 (fax)	Elevation:	
This report should be prepared by the installation of pump.	pump installer in detail and filed with the Depa	artment within 30 days of the	
Well Owner Information		Well Location	
Owner Name: Mark Niche	la Latitude	Longitude:	
Mailing Address:/ / / / /			
	Method of Lat/Long (cir	rcle one): Conventional Survey,	
	USGS quad,	Hand-held GPS, Survey-grade GP	
City / State	38801¼¼ se	ec TwnS_Rng4	
City ' / State	Zip Code Distance Direct		
Telephone No. ()		itolicet foun	
		of Enduille	
Ритр Туре		Power Type	
Circle one		Circle one	
Air Lift Jet	Submersible Diesel Engine G	asoline Engine Natural Ga	
Bucket Piston			
	-	Other (specify):	
Other (specify):	,	Motor: <u>2</u> HP	
Date Pump Installed: <u>\$-1-0</u>		315feet	
Rated Pump Capacity:/ (,G	Gallons Per Minute Number of Stages:	28	
Pump Test Data Date Well Tested: ?- /	/ Method o	Method of Measuring Water Level Circle one	
Static Water Level (A): Z 8 0 Feet B	elow Land Surface	Measuring Line Steel Tape	
Pumping Water Level (B):Feet Be	Conter (specify):		
Drawdown [(B) (A)]:Feet Bo			
Test Pumping Rate:G		red shut in head:fee	
		GPM with a drawdown of	
Duration of Pump Test (minimum 4 hours):	hoursfeet ai	fterhours of pumpin	
· · · · · · · · · · · · · · · · · · ·			
HEREBY CERTIFY that the above statement	nts are true to the best of my knowledge		
Leeper Drilling #	0079		
rint Name of Pump Installer and License No.	(if applicable) Signature of Pur	mpInstaller	
•		RECEIVE	
		SEP 2 8 2006	
		BY: OLW	