

REPAIR

MISSISSIPPI
BOARD OF WATER COMMISSIONERS
416 North State Street
Jackson, Mississippi 39201

WATER WELL DRILLERS LOG

Pontotoc
D2000
9-67

date well completed 9-8-67 firm name LAMAR WILBER county well located PONTOTOC

LANDOWNER: FRANK FORTNER
RT-1 - BELDEN, MISS.
(mailing address)

WELL LOCATION:
sec. 3 T. 9 S. R. 4 E.
3 miles SW of SAERMAN
(distance) (direction) (nearest town)

WELL PURPOSE:
(home, irrigation, municipal, industrial)

WELL COMPLETION DATA:

(1) diameter (inches) 4

(2) total depth (feet) 480

(3) static water level (feet) 162 below above top of ground.

(4) casing Steel, unknown
(material) (depth)

_____ if telescope see back.
(size)

(5) screen _____
(length) (depth to top)

_____ (size) _____ (material)

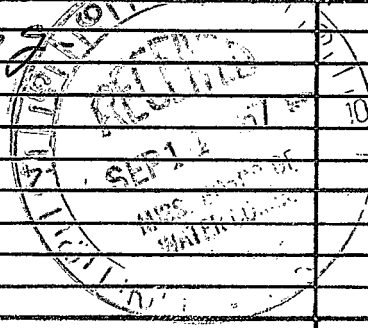
(6) pump _____ (HP) _____ (yield gpm)

_____ (type power)

(7) electric log _____ (yes or no)

_____ (organization running log)

(8) how well bottom plugged _____

description of formations encountered	from	to
we were asked to check this well and perform necessary repairs.		
we found the well pumping mud - (APA - 40% holes)		
We went into well with drill tools and found plug at 352' - we drilled through this and washed out to a total depth of 480'.		
then pulled out and installed drop pipe as per sketch on reverse side.		
then pl - installed customer's rod pump - water is clear after 75 hrs intermittent pumping.		
THIS IS A REPAIR LOG		
DO NOT WRITE IN THESE SPACES		
		

DRILLERS REMARKS:

If well telescopes please sketch and show depths.

1/4 HP. DEMPSTER ROL PUMP

GROUND LEVEL

10 FEET casing -

ESTIMATE 3H

2" CYLINDER

210'

2" TAIL PIPE

252'

OPEN HOLE - 18'

2" SOLID PIPE 147'

2" PER FORSTNER PIPE - 63'

1/2" RUBBER JOINT CLOSURE SET AT 210'

			0

SECTION 3

Please indicate well location X.

ADDITIONAL INFORMATION

If more than one screen, show locations of each on sketch.