

Pontotoc
 D 2001
 12/3/76

MISSISSIPPI
 BOARD OF WATER COMMISSIONERS
 416 North State Street
 Jackson, Mississippi 39201

13C

WATER WELL DRILLERS LOG

Dec 3 1976 J.W. Wehler & Son Pontotoc
 date well completed firm name county well located

LANDOWNER: Taylor J. White
 Sherman
 miss
 (mailing address)

Description of formations encountered	from	to
Soil	0	1
Shale & Clay	1	37
Blue Rock	37	350
Water Rock	350	351
Water sand	351	460
Coarse sand		

WELL LOCATION:
 sec. 10 T. 95 N R. 4 E
 3 miles S of Sherman
 (distance) (direction) (nearest town)

WELL PURPOSE:
 (home, irrigation, municipal, industrial)

WELL COMPLETION DATA:

- diameter (inches) 5.11
- total depth (feet) 460 ft
- static water level (feet) 180 below above top of ground.
- casing Steel 43 ft
 (material) (depth)
 _____ If telescope see back.
 (size)
- screen 0 0
 (length) (depth to top)
 _____ (size) _____ (material)
- pump Rod pump 3
 (HP) (yield gpm)
Elec
 (type power)
- electric log no
 (yes or no)
 _____ (organization running log)
- how well bottom plugged _____

RECEIVED


DEC 9 1976

MISS. BD. OF WATER COMM

DRILLERS REMARKS:

If well telescopes please sketch and show depths.

GROUND LEVEL

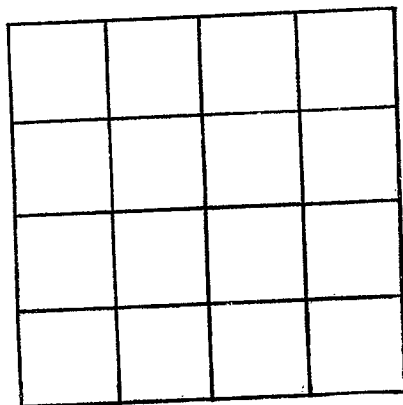

SECTION _____

Please indicate well location X.

ADDITIONAL INFORMATION

If more than one screen, show locations of each on sketch.