

**MISSISSIPPI
BOARD OF WATER COMMISSIONERS**
416 North State Street
Jackson, Mississippi 39201

PONTOTOC
D 2000
5/27/77

13C

WATER WELL DRILLERS LOG

May 27 1977 J. W. Webb & Son Pontotoc
date well completed firm name county well located


LANDOWNER: <u>J. T. Boatner</u>	description of formations encountered	from	to
<u>Baldern</u> <u>Miss</u> (mailing address)			
WELL LOCATION: sec. <u>11</u> T. <u>9S</u> N R. <u>4E</u> <u>4</u> miles <u>N West</u> of <u>Baldern</u> (distance) (direction) (nearest town)	<u>Soil</u> <u>Sand</u> <u>Gravel</u> <u>Blue Rock</u> <u>Water Rock</u> <u>Water Sand</u> <u>Coffee Sand</u>	<u>0</u> <u>1</u> <u>10</u> <u>35</u> <u>315</u> <u>317</u> <u>460</u>	<u>1</u> <u>10</u> <u>35</u> <u>315</u> <u>317</u> <u>460</u>
WELL PURPOSE: (home, irrigation, municipal, industrial)			
WELL COMPLETION DATA: (1) diameter (inches) <u>5</u> (2) total depth (feet) <u>460'</u> (3) static water level (feet) <u>170</u> below top of ground. (4) casing <u>Steel</u> <u>4.5'</u> (material) (depth) <u>5"</u> if telescope see back. (size) (5) screen <u>0</u> <u>0</u> (length) (depth to top) (size) (material) (6) pump <u>0</u> <u>0</u> (HP) (yield gpm) <u>0</u> (type power) (7) electric log _____ (yes or no) (organization running log) (8) how well bottom plugged _____			
DRILLERS REMARKS:			

RECEIVED
JUN 9 1977

MISS. BD. OF WATER COMMISSIONERS

If well telescopes please sketch and show depths.

GROUND LEVEL

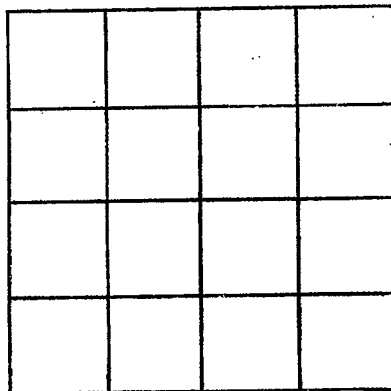

SECTION _____

Please indicate well location X.

ADDITIONAL INFORMATION

If more than one screen, show locations of each on sketch.