

**MISSISSIPPI DEPARTMENT OF ENVIRONMENTAL QUALITY**  
Office of Land and Water Resources

P. O. Box 10631  
Jackson, MS 39289-0631  
WATER WELL DRILLERS LOG

COUNTY WELL LOCATED  
**POWERS**

WELL NUMBER	CODED
1	

D-2004

DATE WELL COMPLETED  
8-14-2002

PERMIT NUMBER

NAME OF DRILLING FIRM  
**PARKS & PARKS WELL SERVICES**  
**HOUSTON, MS 38857**

NAME & MAILING ADDRESS OF LANDOWNER  
**Buddy Fairly**  
**112 RED SHOE RUN**  
**SALTILLO MS. 38866**

Latitude:  
Longitude:

WELL LOCATION. SEC TOWNSHIP RANGE  
**31 8 N 4 E**

DISTANCE DIRECTION NEAREST TOWN  
Miles of

OTHER LANDMARK

WELL PURPOSE: Home, Irrigation, Municipal, Industrial, Fish Pond, etc.  
**Home**

**PUMP DATA**

PUMP TYPE (Circle One):  
**Submersible** Turbine, Jet, Flowing Well,  
Other (Describe)

POWER TYPE (Circle One):  
**Electric** Tractor, Diesel, Gasoline, Butane,  
Other (Describe) **H/P**

DESCRIPTION OF FORMATIONS ENCOUNTERED	FROM	TO
<b>SAND</b>	0	60
<b>CLAY</b>	60	120
<b>SAND</b>	120	160

**RECEIVED**  
**OCT 17 2002**  
**BY: OLWR**

**WELL DATA**

Well Depth <b>160</b>	Casing Diameter (In.) <b>4</b>	Casing Length (Ft.) <b>120</b>
Type of Casing <b>PVC</b>	Hole Depth <b>160</b>	Depth to Static Water Level

TYPE OF COMPLETION: (Circle One or More):  
**Gravel Pack** Underreamed, Telescoped,  
Natural Development, Open Hole, Other  
(Describe)

WELL GROUTED TO A DEPTH OF **10** FEET  
Type Grout (circle one) **Cement**, Bentonite, or Mix

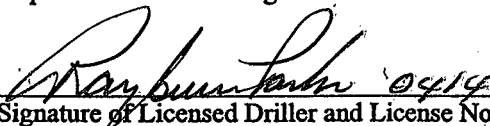
**SCREEN DATA**

Diameter - Inches <b>4</b>	Length - Feet <b>40</b>	Slot Size - Inches <b>.012</b>
Screen Type <b>PVC</b>	Depth to Bottom - Feet	

Top of Lap Pipe or Reduction in Casing

FEET IF TELESCOPED OR MORE THAN ONE SCREEN: USE BACK PAGE

I certify that the well was drilled, constructed and completed in accordance with all applicable Requirements of the Mississippi Department of Environmental Quality and/or the Mississippi Department of Health regulations and state laws.

  
Signature of Licensed Driller and License No.

**10-8-2002**  
Date

Additional Information Required On Back

If well telescopes please sketch and show depths.

GROUND LEVEL

X			

SECTION 31

Please indicate well location X.

Pump Capacity (GPM) <u>8</u>	No. of Stages	Setting Depth <u>147</u> FT.
---------------------------------	---------------	---------------------------------

PUMP TEST

Well yielded \_\_\_\_\_ GPM with  
a drawdown of \_\_\_\_\_ ft.  
after \_\_\_\_\_ hours of pumping

LOG DATA

TYPE OF LOG RUN (Circle One):  No Log Run,  Electric,  Gamma Ray,  Density,  Sonic,  Neutron, Other (Describe) \_\_\_\_\_

Name of Organization Running Log \_\_\_\_\_

GEOLOGIC DATA (Office Use Only)

Surface Elev.	Geologic Unit	Unit Thickness	Depth to Top
Subs. SWL	Date	Analysis	Aquifer Test

Driller's Remarks

---



---



If more than one screen, show location of each on sketch.