

PONTOTOC

E-12  
3-30-62

WATER WELL DRILLERS LOG

CODED

Date: 3-30, 1962 Driller: J. L. ... County: Pontotoc  
(Name)

(1) Owner of Land: Marvin ...  
(Name)  
Randolph  
(Address)

(2) Location: 1/4, S1/4, Sec. 26 T14R14  
1/2 miles west of Randolph  
(distance) (direction) (Nearest Town)

(3) Topography: flat  
(Hilly) (Flat) (Level)

(4) Purpose of Well: Domestic  
(Domestic Irrigation  
Municipal, Industrial, Other)

Description & Color of Materials Sand, Clay, Red Clay, Shell, etc.	Thick-ness Feet	Depth Feet
<u>soil cover</u>	<u>20</u>	<u>20</u>
<u>blue shale</u>	<u>380</u>	<u>400</u>
<u>green sandstone</u>	<u>200</u>	<u>600</u>
<u>red sand</u>	<u>70</u>	<u>670</u>

Information upon completion of well:

(1) Diameter 4 inches.

(2) Total Depth 170 feet.

(3) Water Level 190 feet below top of ground.

(4) Cased to 3/4, Size \_\_\_\_\_


(5) Screen: Size \_\_\_\_\_, Length \_\_\_\_\_

(6) Were any formations sealed against pollution?  
\_\_\_\_\_ yes, \_\_\_\_\_ no.

CODED

If YES depth of formation \_\_\_\_\_  
Why \_\_\_\_\_

Drillers Remarks: \_\_\_\_\_

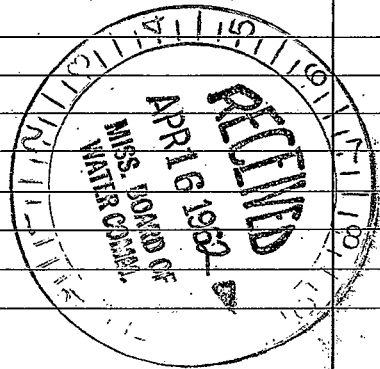

(Use Back Side)

Well No.

1912

1912

...

...

