

MISSISSIPPI DEPARTMENT OF NATURAL RESOURCES

Bureau of Land and Water Resources

Southport Mall

P.O. Box 10631

Jackson, Mississippi 39209

WATER WELL DRILLERS LOG

CODED

Pontotoc
E017

4-3 1986 T.M. Parks Drilling Co. Pontotoc
date well completed firm name county well located

| LANDOWNER: | description of formations encountered | from | to |
|---|---------------------------------------|-------|-------|
| Milton Waldo | Top Soil down to 15 ft. | 0 | 15 |
| Rt. 7 | Dark Clay | 15 | 453 |
| Pontotoc, MS (mailing address) 38863 | Shale Clay and Sand | 453 | 575 |
| WELL LOCATION: | Good Sand | 575 | 580 |
| sec. 11 T 10 N R 1 E S W | Hard Rock | 580 | 581 |
| 3 miles NW of Randolph | Sand | 581 | 584 |
| (distance) (direction) (nearest town) | Rock | 584 | 584.6 |
| WELL PURPOSE: home | Sand | 584.6 | 590 |
| (home, irrigation, municipal, industrial) | Sand and Rock | 590 | 610 |
| WELL COMPLETION DATA: | Sand and Rock | 610 | 630 |
| (1) diameter (inches) 4" | Shale | 630 | 640 |
| (2) total depth (feet) 640 | | | |
| (3) static water level (feet) 200' below top of ground. | | | |
| (4) casing PVC 600' (material) (depth) | | | |
| (size) if telescope see back. | | | |
| (5) screen 30' 600' (length) (depth to top) | | | |
| 4" PVC (size) (material) | | | |
| (6) pump 3/4 15 (HP) (yield gpm) | | | |
| single phase (type power) | | | |
| (7) electric log no (yes or no) | | | |
| (organization running log) | | | |
| (8) how well bottom plugged BPV | | | |

DETECTIVE


APR 10 1986

Department of Natural Resources
Bureau of Land & Water Resources

DRILLERS REMARKS:

If well telescopes please sketch and show depths.

GROUND LEVEL

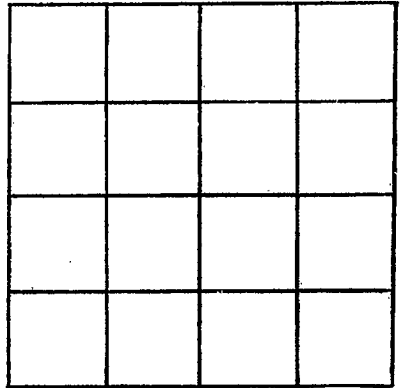

SECTION _____

Please indicate well location X.

ADDITIONAL INFORMATION

If more than one screen,
show locations of each on sketch.