

MISSISSIPPI DEPARTMENT OF NATURAL RESOURCES

Bureau of Land and Water Resources

Southport Mall

P.O. Box 10631

Jackson, Mississippi 39209

WATER WELL DRILLERS LOG

PONTOTOC
E 2000

FEB 19 87 Leeper Drilling PONTOTOC
 date well completed firm name county well located

LANDOWNER: Benny Jones
Rt 1 Randolph, MS

(mailing address)

WELL LOCATION:

sec. 32 T 10 N R 1 E
 (S) (W)
11 miles S.W. of PONTOTOC
 (distance) (direction) (nearest town)

WELL PURPOSE: HOME
 (home, irrigation, municipal, industrial)

WELL COMPLETION DATA:

- (1) diameter (inches) 4"
- (2) total depth (feet) 575'
- (3) static water level (feet) 150 ^(below) / _{above} top of ground.
- (4) casing PVC, 325',
 (material) (depth)
4" if telescope see back.
 (size)
- (5) screen _____
 (length) (depth to top)
 (size) (material)
- (6) pump 1 11
 (HP) (yield gpm)
ELC
 (type power)
- (7) electric log NO
 (yes or no)
 (organization running log)
- (8) how well bottom plugged OPEN

description of formations encountered

from to

TOP CLAY	0	20
BLUE CLAY	20	100
SOFT SHALE	100	250
CHALK	250	520
SAND	520	575


RECEIVED
 MAR 09 1987

Department of Natural Resources
 Bureau of Land & Water Resources

DRILLERS REMARKS:

If well telescopes please
sketch and show depths.

GROUND LEVEL

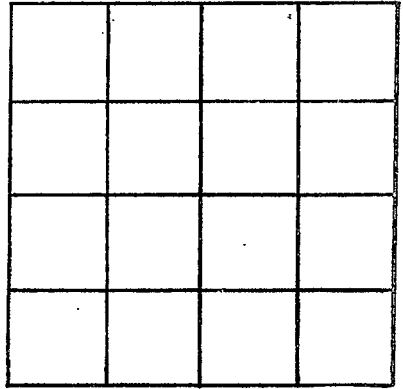

SECTION _____

Please indicate well location X.

ADDITIONAL INFORMATION

If more than one screen,
show locations of each on sketch.