

ELOG 30

PONTATOC

F14

6-71

MISSISSIPPI BOARD OF WATER COMMISSIONERS 416 North State Street Jackson, Mississippi 39201

WATER WELL DRILLERS LOG

CODED

June 1971 J. W. Welch & Sons Pontatoc date well completed firm name county well located

LANDOWNER: Pontatoc Schos

description of formations encountered

from to

Pontatoc, Miss (mailing address)

Soil	0	1
Gravel	1	38
Blue Rock	38	90
Sand & Rocks	90	160
Water Rock	160	164
Water Sand	164	300
Replay Soil		

WELL LOCATION:

sec. 10 T. 105 N R. 7 E S W 1 1/2 miles south of Springville (distance) (direction) (nearest town)

WELL PURPOSE: (home, irrigation, municipal, industrial)

WELL COMPLETION DATA:

- (1) diameter (inches) 10"
- (2) total depth (feet) 300'
- (3) static water level (feet) 60 below top of ground.
- (4) casing steel, 184ft (material) (depth)

CODED

- (5) screen 40' length, 168 depth to top (size) (material)
- (6) pump 15 HP, 150 yield gpm (type power)

- (7) electric log yes (yes or no) U S S (organization running log)

- (8) how well bottom plugged Back Wash Valve

SEP 16 1971


DRILLERS REMARKS:

MISS. BD. OF WATER COMMISSIONERS

7

If well telescopes please sketch and show depths.

GROUND LEVEL

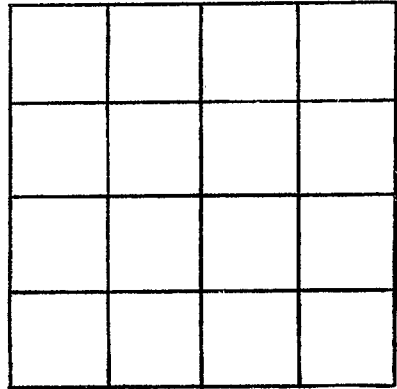

SECTION _____

Please indicate well location X.

ADDITIONAL INFORMATION

If more than one screen,
show locations of each on sketch.