

15 F

MISSISSIPPI
BOARD OF WATER COMMISSIONERS
416 North State Street
Jackson, Mississippi 39201

CODED

WATER WELL DRILLERS LOG

Pontotoc
715
11-2-68

11-2-68 19 LAMAR WELLER Pontotoc
date well completed firm name county well located

LANDOWNER:

description of formations encountered

from to

CHRISTINE GOULD

RT 5 Pontotoc
(mailing address)

WELL LOCATION:

sec. 2 T. 10 N. R. 2 E
S 5
6 miles SW of Pontotoc
(distance) (direction) (nearest town)


WELL PURPOSE: HOME
(home, irrigation, municipal, industrial)

WELL COMPLETION DATA:

- (1) diameter (inches) 4
- (2) total depth (feet) 222
- (3) static water level (feet) 55 below above top of ground.
- (4) casing STEEL, 1 1/4",
(material) (depth)
4" if telescope see back.
(size)
- (5) screen
(length) (depth to top)
(size) (material)
- (6) pump 1/2 HP 8
(HP) (yield gpm)
ELECTRIC
(type power)
- (7) electric log NO
(yes or no)
(organization running log)
- (8) how well bottom plugged

BOCKSHOT	0	30
LIMESTONE	30	36
BLACK SHALE	36	75
BROWN SAND	75	95
BILE SHALE	95	140
ROCK & BROWN SAND	140	170
ROCK & WHITESAND	170	222
BLUE ROCK & SHALE	220	222


CODED

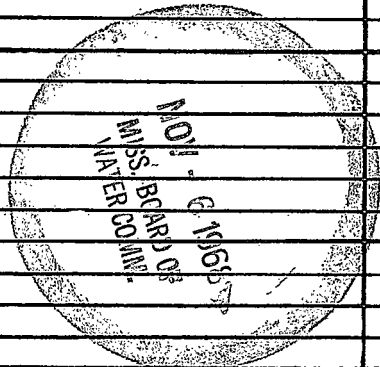

DRILLERS REMARKS:

If well telescopes please sketch and show depths.

GROUND LEVEL

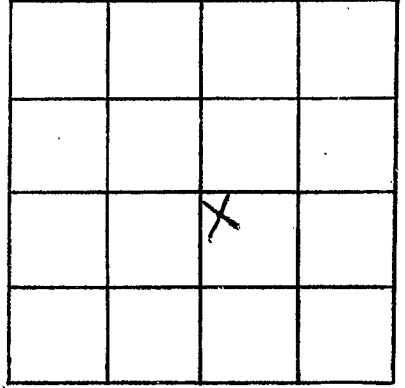

SECTION 2

Please indicate well location X.

ADDITIONAL INFORMATION

If more than one screen,
show locations of each on sketch.