

Pontotoc
F 16
1-27-69

MISSISSIPPI
BOARD OF WATER COMMISSIONERS
416 North State Street
Jackson, Mississippi 39201

CODED

CODED

WATER WELL DRILLERS LOG

1-27 date well completed 1969 firm name *Living Goss Co* Pontotoc county well located

LANDOWNER:
Wagner murphy

(mailing address)

description of formations encountered	from	to
<i>point clay</i>	<i>0</i>	<i>210</i>
<i>blue</i>	<i>40</i>	<i>680</i>
<i>grey sand & clay</i>	<i>130</i>	<i>142</i>
<i>sand</i>	<i>160</i>	<i>241</i>

WELL LOCATION:
sec. *12* *10* N S R. *2* E W
miles _____ of _____
(distance) (direction) (nearest town)

WELL PURPOSE: *home*
(home, irrigation, municipal, industrial)

- WELL COMPLETION DATA:
- (1) diameter (inches) *2 1/2*
 - (2) total depth (feet) *241*
 - (3) static water level (feet) *80'* below above top of ground.
 - (4) casing *CT* *64'*
(material) (depth)

_____ if telescope see back.
(size)
 - (5) screen _____
(length) (depth to top)

_____ (size) _____ (material)
 - (6) pump *3/4* *680*
(HP) (yield gpm)
EP 220
(type power)
 - (7) electric log _____
(yes or no)

_____ (organization running log)
 - (8) how well bottom plugged _____


CODED

FEB 13 1969
MISS. BD. OF
WATER COMMISSIONERS

DRILLERS REMARKS:

If well telescopes please
sketch and show depths.

GROUND LEVEL

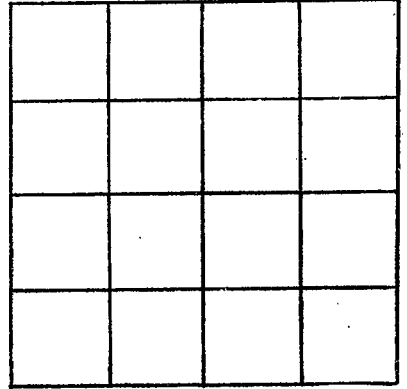

SECTION _____

Please indicate well location X.

ADDITIONAL INFORMATION

If more than one screen,
show locations of each on sketch.