

Pontotoc
7-17
4-8-69

MISSISSIPPI
BOARD OF WATER COMMISSIONERS
416 North State Street
Jackson, Mississippi 39201

WATER WELL DRILLERS LOG

4-8-69 19 LAMAR WILDER PONTOTOC
date well completed firm name county well located

LANDOWNER:
FRANK TUTOR
RT-4, PONTOTOC
(mailing address)

description of formations encountered	from	to
GREY BOCKSHOT-LIMESTONE	0	25
BLUE SHALE	25	70
ROCK & LIMESTONE	70	200
ROCK & SAND	200	250
	250	335

WELL LOCATION:
sec 12 T. 10 N R. 2 E
S W
4 miles SW of PONTOTOC
(distance) (direction) (nearest town)

WELL PURPOSE:
(home, irrigation, municipal, industrial)

WELL COMPLETION DATA:

(1) diameter (inches) 4

(2) total depth (feet) 335

(3) static water level (feet) 90 below top of ground.

(4) casing STEEL, 129, (material) (depth)
4" (size) if telescope see back.

(5) screen (length) (depth to top)
(size) (material)

(6) pump PUMP BY (HP) (yield gpm)
OTHERS (type power)

(7) electric log (yes or no)
(organization running log)

(8) how well bottom plugged


JUN 4 - 1969

MISS. BD. OF
WATER COMM.

DRILLERS REMARKS:

If well telescopes please sketch and show depths.

GROUND LEVEL

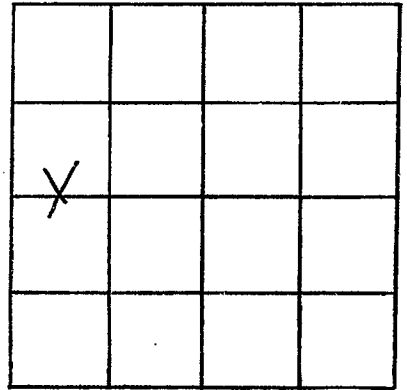

SECTION 12

Please indicate well location X.

ADDITIONAL INFORMATION

If more than one screen,
show locations of each on sketch.