

CODED

MISSISSIPPI
BOARD OF WATER COMMISSIONERS
416 North State Street
Jackson, Mississippi 39201

WATER WELL DRILLERS LOG

Pontotoc
720
5-23-69

May 23 1969 J. W. Webb & Sons Pontotoc
date well completed firm name county well located

LANDOWNER: Buddy Clowan
Pontotoc, Miss

(mailing address)

WELL LOCATION:

sec 9 T 5 N R 2 E
10 S W
5 miles Water of Pontotoc
(distance) (direction) (nearest town)

WELL PURPOSE: home
(home, irrigation, municipal, industrial)

WELL COMPLETION DATA:

- (1) diameter (inches) 5
- (2) total depth (feet) 280
- (3) static water level (feet) 80 below top of ground.
- (4) casing steel 83'
(material) (depth)
 if telescope see back.
(size)
- (5) screen none
(length) (depth to top)
 (size) (material)
- (6) pump 3/4 10
(HP) (yield gpm)
electric
(type power)
- (7) electric log no
(yes or no)
 (organization running log)
- (8) how well bottom plugged

description of formations encountered

from

to

Clay	0	20
sandy clay	20	45
sand	45	60
Blue mud	60	150
water sand	150	280


DRILLERS REMARKS:

MISS. BD. OF
WATER COMMISSIONERS

MAY 9 - 1969

If well telescopes please sketch and show depths.

GROUND LEVEL

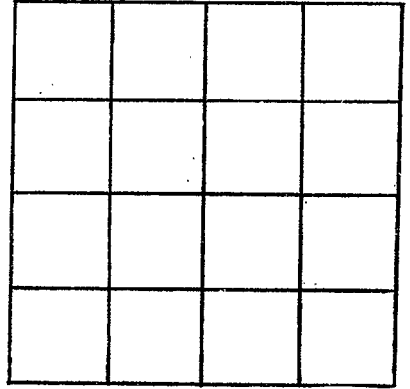

SECTION 29

Please indicate well location X.

ADDITIONAL INFORMATION

If more than one screen,
show locations of each on sketch.