

MISSISSIPPI
 BOARD OF WATER COMMISSIONERS
 416 North State Street
 Jackson, Mississippi 39201

WATER WELL DRILLERS LOG

Aug 19 69 J. W. Webb & Sons Pontotoc
 date well completed firm name county well located

LANDOWNER: Lerry Montgomery

description of formations encountered

Pontotoc miss
 (mailing address)

description of formations encountered	from	to
<u>Soil</u>	<u>0</u>	<u>7</u>
<u>pipe clay</u>	<u>7</u>	<u>50</u>
<u>Blue Rock</u>	<u>50</u>	<u>160</u>
<u>Water sand</u>	<u>160</u>	<u>220</u>
<u>Replay Formation</u>		

WELL LOCATION:
 sec. 16 T. 103N S R. 2 E W
2 miles South of Springville
 (distance) (direction) (nearest town)

WELL PURPOSE:
 (home, irrigation, municipal, industrial)

WELL COMPLETION DATA:


- (1) diameter (inches) 4
- (2) total depth (feet) 220
- (3) static water level (feet) 87 below above top of ground.
- (4) casing Steel, 58 (material), (depth)
4 (size) if telescope see back.
- (5) screen _____ (length) _____ (depth to top)
 _____ (size) _____ (material)
- (6) pump 0 (HP) 0 (yield gpm)
0 (type power)
- (7) electric log _____ (yes or no)
 _____ (organization running log)
- (8) how well bottom plugged _____

SEP 26 1969
 MISS. RD. OF
 WATER COMMISSIONERS

DRILLERS REMARKS:

If well telescopes please sketch and show depths.

GROUND LEVEL

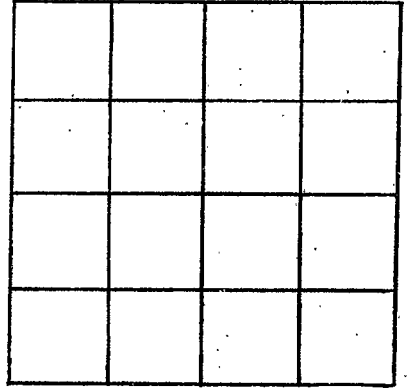

SECTION 16

Please indicate well location X.

ADDITIONAL INFORMATION

If more than one screen,
show locations of each on sketch.