

Pontotoc
F22
5-13-70

MISSISSIPPI
 BOARD OF WATER COMMISSIONERS
 416 North State Street
 Jackson, Mississippi 39201

WATER WELL DRILLERS LOG

5-13-70 1970 LAMAR WILDER PONTOTOC
 date well completed firm name county well located

LANDOWNER:
Mrs. W.E. Watts
Algona miss
 (mailing address)

WELL LOCATION:
 sec. 23 T. 10 R. 2 165
8 miles SW of PONTOTOC
 (distance) (direction) (nearest town)

| description of formations encountered | from | to |
|---------------------------------------|------------|------------|
| <u>Red Clay</u> | <u>0</u> | <u>20</u> |
| <u>GIBEL ROCKSHOT</u> | <u>20</u> | <u>45</u> |
| <u>LIMESTONE</u> | <u>45</u> | <u>90</u> |
| <u>BLUE SHALE</u> | <u>90</u> | <u>200</u> |
| <u>ROCK & SAND</u> | <u>200</u> | <u>276</u> |

WELL PURPOSE: HOME
 (home, irrigation, municipal, industrial)

WELL COMPLETION DATA:

(1) diameter (inches) 4

(2) total depth (feet) 276

(3) static water level (feet) 90 below above top of ground.

(4) casing STEEL, 102,
 (material) (depth)
4"
 (size) if telescope see back.

(5) screen None
 (length) (depth to top)
 (size) (material)

(6) pump 1/2 5
 (HP) (yield gpm)
ELECT
 (type power)

(7) electric log NO
 (yes or no)
 (organization running log)

(8) how well bottom plugged _____


JUN 4 1970

MISS. BD. OF
 WATER COMM.

DRILLERS REMARKS: _____

If well telescopes please sketch and show depths.

GROUND LEVEL

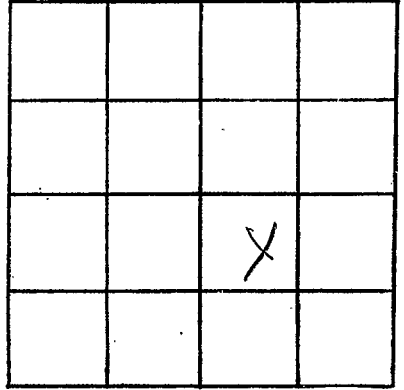

SECTION _____

Please indicate well location X.

ADDITIONAL INFORMATION

If more than one screen,
show locations of each on sketch.