

PONTOTOC

F 25

8-31-70

MISSISSIPPI  
 BOARD OF WATER COMMISSIONERS  
 416 North State Street  
 Jackson, Mississippi 39201

**CODED**

WATER WELL DRILLERS LOG

8-31-70

date well completed

LAMAR WILDER

firm name

PONTOTOC

county well located

LANDOWNER:

L-A-GATES

description of formations encountered

from

to

1374 PONTOTOC  
(mailing address)

GREY BUCKSHOT  
LIMESTONE  
BLUE SHALE  
ROCK & SAND

0 40  
46 90  
90 170  
170 255

WELL LOCATION:

sec. 14 T. 10N R. 2E  
S 5  
1/4 miles SW of PONTOTOC  
(distance) (direction) (nearest town)

WELL PURPOSE: HOME  
(home, irrigation, municipal, industrial)

WELL COMPLETION DATA:

- (1) diameter (inches) 4
- (2) total depth (feet) 265
- (3) static water level (feet) 70 below top of ground.
- (4) casing STEEL, 121  
(material) (depth)

**CODED**

(size) if telescope see back.

- (5) screen NON C  
(length) (depth to top)

(size) (material)

- (6) pump PUMP  
(HP) (yield gpm)  
BY OTHERS  
(type power)

- (7) electric log (yes or no)

(organization running log)

- (8) how well bottom plugged


SEP 28 1970

DRILLERS REMARKS:

MISS. BD. OF  
WATER COMM.

If well telescopes please sketch and show depths.

GROUND LEVEL

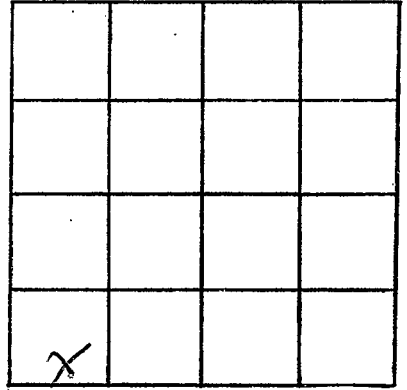

SECTION \_\_\_\_\_

Please indicate well location X.

ADDITIONAL INFORMATION

If more than one screen, show locations of each on sketch.