

PONTOTOC

F26

9-3-70

MISSISSIPPI BOARD OF WATER COMMISSIONERS  
416 North State Street  
Jackson, Mississippi 39201

**CODED**

WATER WELL DRILLERS LOG

9-3-70

date well completed

LAMAR WILDER

firm name

PONTOTOC

county well located

LANDOWNER:

MAS-DE-SAPPHIRE

description of formations encountered

from

to

RT 4 - PONTOTOC  
(mailing address)

BUCKSHOT

0 90

LIMESTONE

40 90

BLUE SAND

90 170

ROCK + SAND

170 200

WELL LOCATION:

sec 4 T 10 S R 2 E

4 miles SW of PONTOTOC  
(distance) (direction) (nearest town)

WELL PURPOSE: HOME  
(home, irrigation, municipal, industrial)

WELL COMPLETION DATA:

- (1) diameter (inches) 4
- (2) total depth (feet) 260
- (3) static water level (feet) 70 below top of ground.

(4) casing STEEL 1 1/2"  
(material) (depth)

48 if telescope see back.  
(size)

(5) screen NAAM  
(length) (depth to top)

(size) (material)

(6) pump 1/2 5  
(HP) (yield gpm)

ELECT  
(type power)

(7) electric log NO  
(yes or no)

(organization running log)

(8) how well bottom plugged

DRILLERS REMARKS:


**CODED**

SEP 28 1970

MISS. BD. OF  
WATER COMM.

If well telescopes please sketch and show depths.

GROUND LEVEL

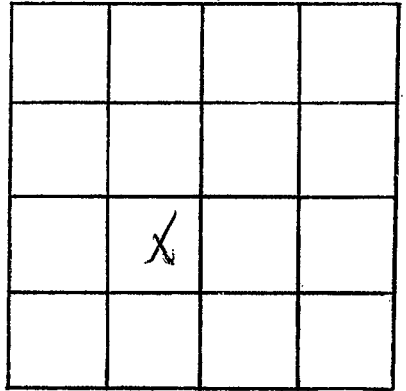

SECTION \_\_\_\_\_

Please indicate well location X.

ADDITIONAL INFORMATION

If more than one screen,  
show locations of each on sketch.