

Pontotoc
F 29
6-10-70

MISSISSIPPI
BOARD OF WATER COMMISSIONERS
416 North State Street
Jackson, Mississippi 39201

CODED

WATER WELL DRILLERS LOG

6-10-1970 date well completed
Leeper Drilling Co. firm name
Pontotoc county well located

LANDOWNER:
D. L. Ward
Rt 4 Pontotoc
(mailing address)

description of formations encountered	from	to
Grey clay	0	40
Blue clay	110	160
Blue clay	160	250
Chalk	250	300
Sand	300	365

WELL LOCATION:
sec. 9 T 10 S R 2 E
5 miles W of Pontotoc
(distance) (direction) (nearest town)

WELL PURPOSE: home
(home, irrigation, municipal, industrial)

WELL COMPLETION DATA:

- (1) diameter (inches) 4
- (2) total depth (feet) 365
- (3) static water level (feet) 60 below top of ground
- (4) casing Steel, 147, (material) (depth)
4 (size) if telescope see back.
- (5) screen none (length) (depth to top)
- (6) pump 2 (HP) 18 (yield gpm)
E. Jet (type power)
- (7) electric log no (yes or no)
- (8) how well bottom plugged

CODED


JUN 30 1970

DRILLERS REMARKS:

MISS. BD. OF
WATER COMM.

If well telescopes please sketch and show depths.

GROUND LEVEL

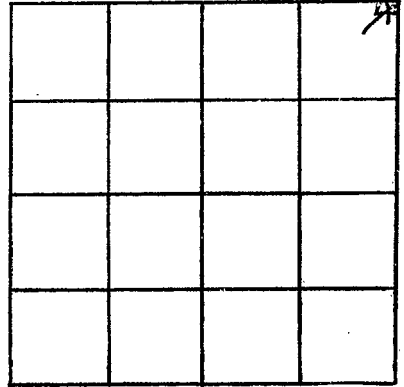

SECTION 9

Please indicate well location X.

ADDITIONAL INFORMATION

If more than one screen,
show locations of each on sketch.