

PONTOTOC
F32
12-4-70

MISSISSIPPI
 BOARD OF WATER COMMISSIONERS
 416 North State Street
 Jackson, Mississippi 39201

CODED

WATER WELL DRILLERS LOG

Dec 4 1970 J. W. Webb & Son Pontotoc
 date well completed firm name county well located

LANDOWNER: <u>Randy Winters</u>	description of formations encountered	from	to
<u>algoma miss</u> (mailing address)	<u>Soil</u>	<u>0</u>	<u>10</u>
	<u>Sand & Rocks</u>	<u>10</u>	<u>55</u>
WELL LOCATION: sec. <u>30</u> T. <u>105</u> N. R. <u>2</u> E	<u>Blue Rock</u>	<u>55</u>	<u>97</u>
	<u>Water Rock</u>	<u>97</u>	<u>99</u>
(distance) <u> </u> miles (direction) <u> </u> of (nearest town) <u> </u>	<u>Water Sand & Rocks</u>	<u>99</u>	<u>188</u>
WELL PURPOSE: (home, irrigation, municipal, industrial)	<u>Ripley Sand</u>		
WELL COMPLETION DATA:			
(1) diameter (inches) <u>4</u>			
(2) total depth (feet) <u>180</u>			
(3) static water level (feet) <u>70</u> below top of ground.			
(4) casing <u>Steel</u> <u>62</u> (material) (depth)			
<u>4"</u> if telescope see back. (size)			
(5) screen <u>0</u> <u>0</u> (length) (depth to top)			
<u>0</u> <u>0</u> (size) (material)			
(6) pump <u>Jet Pump</u> <u>4</u> (HP) (yield gpm)			
<u>Elec</u> (type power)			
(7) electric log <u>0</u> (yes or no)			
(organization running log)			
(8) how well bottom plugged <u>Open</u>			
DRILLERS REMARKS:			


CODED

JAN 22 1971

MISS. BD. OF
 WATER COMMISSIONERS

If well telescopes please sketch and show depths.

GROUND LEVEL

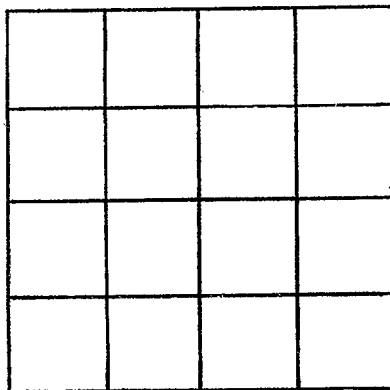

SECTION _____

Please indicate well location X.

ADDITIONAL INFORMATION

If more than one screen, show locations of each on sketch.