

PONTOTOC MISSISSIPPI BOARD OF WATER COMMISSIONERS

F-35

9-1-60

WATER WELL DRILLERS LOG

F-300

Date: Sept 1, 1960, Driller: J L Mays County: Pontotoc  
(Name)

**CODED**  
 (1) Palmer Graham  
(Name)

(Address)

(2) Location: 2 1/2 corner of road  
1/4, 7 1/4 1/4, Sec. 7 T10 R24

1 miles west, of Pontotoc  
(distance) (direction) (Nearest Town)

(3) Topography: hilly  
(Hilly) (Flat) (Level)

(4) Purpose of Well: Domestic  
(Domestic Irrigation Municipal, Industrial, Other)

Description & Color of Materials Sand, Clay, Red Clay, Shell, etc.	Thick- ness- Feet	Depth Feet
<u>Soft brown clay</u>	<u>40</u>	<u>60</u>
<u>Rock &amp; sand</u>	<u>50</u>	<u>90</u>
<u>Blue marl</u>	<u>68</u>	<u>160</u>
<u>Rock &amp; sand</u>	<u>28</u>	<u>190</u>

Information upon completion of well:

(1) Diameter 4 inches.

(2) Total Depth 190 feet.

(3) Water Level 100 feet below top of ground.

(4) Cased to 105, Size 4"

(5) Screen: Size \_\_\_\_\_, Length \_\_\_\_\_


(6) Were any formations sealed against pollution?  
 \_\_\_\_\_ yes, \_\_\_\_\_ no.

If YES depth of formation \_\_\_\_\_

Why \_\_\_\_\_

Drillers Remarks: \_\_\_\_\_

**CODED**

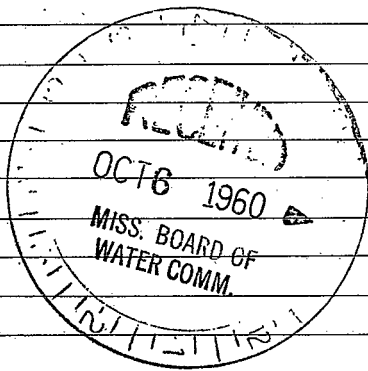

Well No.  
F-300

(Use Back Side)

[The page contains extremely faint and illegible text, likely bleed-through from the reverse side of the document. The text is scattered across the page and cannot be transcribed accurately.]