

PONTOTOC

F-36

3-16-62

WATER WELL DRILLERS LOG

Date: **CODED** 9/2 Driller: J. S. [unclear] County: Pontotoc
(Name)

(1) Owner of Land: Lee S. Lyons
(Name)
Pontotoc R. 4, D 5
(Address)

(2) Location: 1/4, SE 1/4, Sec. 17, T. 12 N. R. 26 E.
4 miles southwest of Pontotoc
(distance) (direction) (Nearest Town)

(3) Topography: X
(Hilly) (Flat) (Level)

(4) Purpose of Well: Domestic
(Domestic Irrigation
Municipal, Industrial, Other)

Description & Color of Materials Sand, Clay, Red Clay, Shell, etc.	Thick- ness Feet	Depth Feet
<u>Clay shale</u>	<u>30</u>	<u>30</u>
<u>Red shale</u>	<u>105</u>	<u>135</u>
<u>Red sandstone</u>	<u>25</u>	<u>160</u>
<u>Grey formation</u>	<u>20</u>	<u>180</u>
<u>sand</u>	<u>10</u>	<u>190</u>

Information upon completion of well:

(1) Diameter 4 inches.

(2) Total Depth 275 feet.

(3) Water Level 72 feet below top of ground.

(4) Cased to 105, Size 4".


(5) Screen: Size _____, Length _____.

(6) Were any formations sealed against pollution?
_____ yes, _____ no.

CODED

If YES depth of formation _____
Why _____

Drillers Remarks: _____

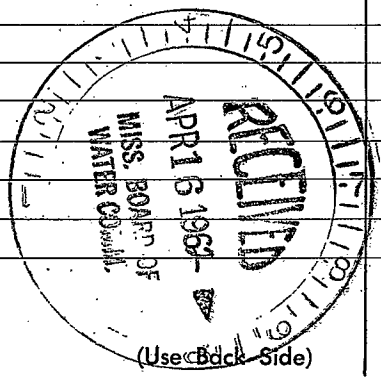

Well No.

