

F-38

5-26-62

WATER WELL DRILLERS LOG

CODED

Date: 5-26, 1962. Driller: J L Mackey County: Pontotoc
 (Name)

CODED

(1) Owner of Land: Lawrence Mackey
 (Name)
Pontotoc, Miss.
 (Address)

(2) Location: 1/4, NW 1/4, Sec. 27, T10R16
6 miles west of Pontotoc
 (distance) (direction) (Nearest Town)

(3) Topography: Flat
 (Hilly) (Flat) (Level)

(4) Purpose of Well: Domestic
 (Domestic Irrigation
 Municipal, Industrial, Other)

Description & Color of Materials Sand, Clay, Red Clay, Shell, etc.	Thick- ness Feet	Depth Feet
<u>Sand & clay</u>	<u>36</u>	<u>36</u>
<u>Blue shale</u>	<u>70</u>	<u>106</u>
<u>rock & gravel & sand</u>	<u>35</u>	<u>140</u>
<u>Gravel</u>	<u>7</u>	<u>147</u>
<u>Blue gravel</u>	<u>30</u>	<u>177</u>
<u>Gravel & sand</u>	<u>45</u>	<u>222</u>


Information upon completion of well:

- (1) Diameter: 4 inches.
- (2) Total Depth: 226 feet.
- (3) Water Level: 36 feet below top of ground.
- (4) Cased to: 63, Size: 4"
- (5) Screen: Size _____, Length _____
- (6) Were any formations sealed against pollution?
 _____ yes, _____ no.

If YES, depth of formation _____
 Why _____

Drillers Remarks: _____

CODED

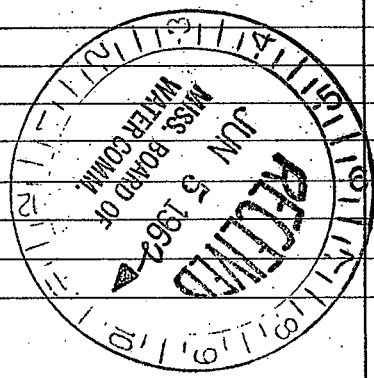

(Use Back Side)

Well No.

1948

Dear Mr. [Name],

I have received your letter of the 15th and am glad to hear from you. I am sorry that I cannot give you a more definite answer at this time, but I am sure that you will understand my position. I am sure that you will find the information I have given you satisfactory.

I am sure that you will find the information I have given you satisfactory.

Very truly yours,

[Name]

[Address]

[City, State, Zip]

[Phone Number]

[Additional Information]

[Closing Remarks]

[Signature]

[Title]

[Company Name]

[Address]

[City, State, Zip]

[Phone Number]