

CODED

CODED

Pontotoc
740
8-67

MISSISSIPPI
BOARD OF WATER COMMISSIONERS
416 North State Street
Jackson, Mississippi 39201

WATER WELL DRILLERS LOG

8-1-67 1967 LAMAR WILDER PONTOTOC
date well completed 8-1-67 firm name county well located

LANDOWNER:
H-E. SWANSON
P.O. 5 - PONTOTOC, MISS
(mailing address)


description of formations encountered	from	to
	BOCKSHOT	0
BLUE SHALE	110	150
ROCK & SAND	150	220

WELL LOCATION:
sec 2 T 10 N R 2 E
6 miles SW of PONTOTOC
(distance) (direction) (nearest town)

WELL PURPOSE:
(home, irrigation, municipal, industrial)

- WELL COMPLETION DATA:
- (1) diameter (inches) 4
 - (2) total depth (feet) 220
 - (3) static water level (feet) 60 below top of ground.
 - (4) casing STEEL, 115
(material) (depth)
_____ if telescope see back.
(size)
 - (5) screen NONE
(length) (depth to top)
(size) (material)
 - (6) pump 3/4 5
(HP) (yield gpm)
(type power)
 - (7) electric log NO
(yes or no)
(organization running log)
 - (8) how well bottom plugged _____

CODED

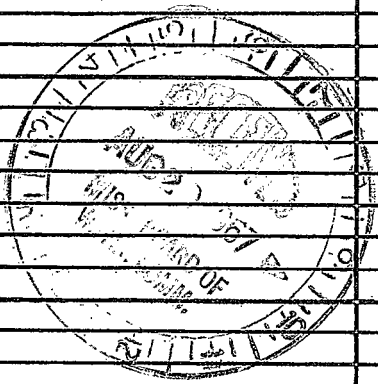

DRILLERS REMARKS:

If well telescopes please sketch and show depths.

GROUND LEVEL

	X		

SECTION 2

Please indicate well location X.

ADDITIONAL INFORMATION

If more than one screen, show locations of each on sketch.