

CODED

Pontotoc

F-41

8-67

MISSISSIPPI
BOARD OF WATER COMMISSIONERS
416 North State Street
Jackson, Mississippi 39201

WATER WELL DRILLERS LOG

8-9-
date well completed

1967 Fwing Gas Co. Inc.
firm name

Pontotoc
~~LEE~~
county well located

LANDOWNER: *Tinsley Galloway*

description of formations encountered

from to

Pontotoc, Miss
(mailing address)

*Clay
Blue
Sand*

*0 30
50 90
90 210*

WELL LOCATION:

sec. 33 T. 10 N. R. 2 E.
S. W. N. W.
10 miles SW of Pontotoc
(distance) (direction) (nearest town)

WELL PURPOSE: *Home*
(home, irrigation, municipal, industrial)


WELL COMPLETION DATA:

- (1) diameter (inches) 4"
- (2) total depth (feet) 210'
- (3) static water level (feet) _____ below above top of ground.
- (4) casing CT, 33',
(material) (depth)
_____ if telescope see back.
(size)
- (5) screen _____
(length) (depth to top)
_____ (size) (material)

- (6) pump 1/2 670
(HP) (yield gpm)
110 EI.
(type power).
- (7) electric log _____
(yes or no)
_____ (organization running log)
- (8) how well bottom plugged _____


DRILLERS REMARKS:

CODED

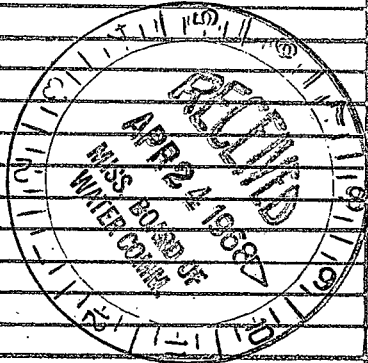

If well telescopes please sketch and show depths.

GROUND LEVEL

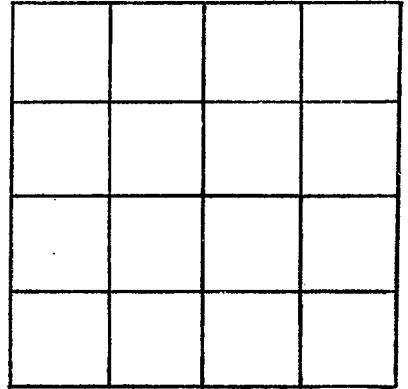

SECTION _____

Please indicate well location X.

ADDITIONAL INFORMATION

If more than one screen,
show locations of each on sketch.