

CODED

Pontotoc
742
8-67

**MISSISSIPPI
BOARD OF WATER COMMISSIONERS**
416 North State Street
Jackson, Mississippi 39201

WATER WELL DRILLERS LOG

8-22-67 19 LAMAR WILDER PONTOTOC
 date well completed firm name county well located

LANDOWNER:
C. JONES

description of formations encountered	from	to
	<u>GREY BOCKSNOT</u>	<u>0</u>
<u>BLUE SHALE</u>	<u>90</u>	<u>140</u>
<u>ROCK + SAND-</u>	<u>140</u>	<u>232</u>

RT-5-Box-37-PONTOTOC
(mailing address) MISS


WELL LOCATION:
 sec 2 T. 10 N R. 2 E
 S W
5 1/2 miles SW of Pontotoc
 (distance) (direction) (nearest town)

WELL PURPOSE:
(home, irrigation, municipal, industrial)

WELL COMPLETION DATA:

- (1) diameter (inches) 4
- (2) total depth (feet) 232
- (3) static water level (feet) 60 below above top of ground.
- (4) casing STEEL, 100
 (material) (depth)
 _____ if telescope see back.
 (size)
- (5) screen _____
 (length) (depth to top)
 _____ (size) _____ (material)
- (6) pump NO PUMP
 (HP) (yield gpm)
INSTALLED BY
 (type power) US-
- (7) electric log _____
 (yes or no)
 _____ (organization running log)
- (8) how well bottom plugged _____


CODED

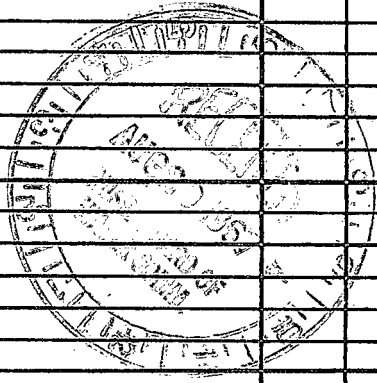

DRILLERS REMARKS:

If well telescopes please sketch and show depths.

GROUND LEVEL

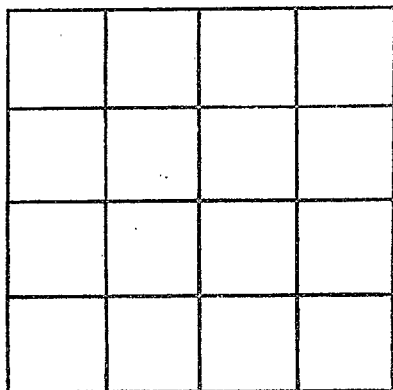

SECTION 2

Please indicate well location X.

ADDITIONAL INFORMATION

WE CONTRACTED
TO FURNISH CASINGS
AND DRILLING ONLY

PUMP TO BE FURNISHED
AND INSTALLED BY
OTHERS ~

If more than one screen,
show locations of each on sketch.