

CODED

MISSISSIPPI
 BOARD OF WATER COMMISSIONERS
 416 North State Street
 Jackson, Mississippi 39201

CODED

WATER WELL DRILLERS LOG

Pontotoc
 743
 9-67

9-2-67 19 LAMAR WILDER PONTOTOC
 date well completed firm name county well located

LANDOWNER: Edwood Cooper
RT-4, PONTOTOC
 (mailing address)
 WELL LOCATION:
 sec 11 T 10 S R 2 E
 (distance) miles (direction) of (nearest town)


description of formations encountered	from	to
<u>GREY BUCKSHOT</u>	<u>0</u>	<u>30</u>
<u>BUCKSHOT- LIMESTONE</u>	<u>30</u>	<u>110</u>
<u>BLUE SHALE</u>	<u>110</u>	<u>270</u>
<u>ROCK SAND</u>	<u>270</u>	<u>299</u>

WELL PURPOSE: HOUSE TRAILER
 (home, irrigation, municipal, industrial)

WELL COMPLETION DATA:
 (1) diameter (inches) 4
 (2) total depth (feet) 299
 (3) static water level (feet) 85 below above top of ground.
 (4) casing STEEL, 126,
 (material) (depth)
4" if telescope see back.
 (size)
 (5) screen ~~_____~~
 (length) (depth to top)
 (size) (material)
 (6) pump 3/4 6
 (HP) (yield gpm)
ELECTRIC
 (type power)
 (7) electric log NO
 (yes or no)
 (organization running log)
 (8) how well bottom plugged _____

CASEINS AND PUMP
AS WELL AS ALL OTHER
EQUIPMENT FURNISHED
BY OTHERS -
I WILL NOT ACCEPT
RESPONSIBILITY FOR ANY
MATERIAL THAT GOES DOWN
LOWER WELLS.

CODED

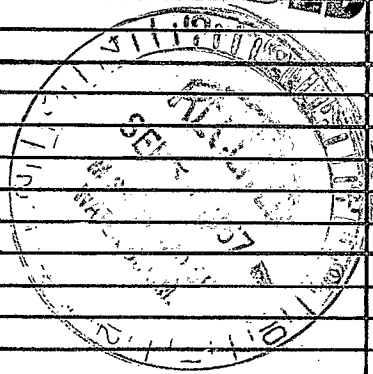

DRILLERS REMARKS:
ALL MATERIAL FURNISHED
BY OTHERS.

If well telescopes please sketch and show depths.

GROUND LEVEL

		D	

SECTION 11

Please indicate well location X.

ADDITIONAL INFORMATION

If more than one screen, show locations of each on sketch.