

CODED

CODED

MISSISSIPPI
 BOARD OF WATER COMMISSIONERS
 416 North State Street
 Jackson, Mississippi 39201

WATER WELL DRILLERS LOG

PONTOTOC
 F 44
 2-68

2-16-68 19 LAMAR WILDER PONTOTOC
 date well completed firm name county well located

LANDOWNER:

W.C. CSNER

RT-1 - ALBAMA, MISS
 (mailing address)

description of formations encountered

from to

<u>GREY BUCKSHOT</u>	<u>0</u>	<u>20</u>
<u>LIMESTONE</u>	<u>20</u>	<u>60</u>
<u>BLUE SHALE</u>	<u>6</u>	<u>160</u>
<u>Block SAND</u>	<u>140</u>	<u>200</u>

WELL LOCATION:

sec. 36 T. 10 N. R. 2 E
 S. 1 miles S of ALBAMA
 (distance) (direction) (nearest town)

WELL PURPOSE: HOME
 (home, irrigation, municipal, industrial)

WELL COMPLETION DATA:

- (1) diameter (inches) 4
- (2) total depth (feet) 266
- (3) static water level (feet) 55 below above top of ground.
- (4) casing STEEL, 110
 (material) (depth)

 if telescope see back.
 (size)

- (5) screen /
 (length) (depth to top)

 /
 (size) (material)

- (6) pump 1 / 7
 (HP) (yield gpm)

ELECTRIC
 (type power)


- (7) electric log
 (yes or no)

 (organization running log)

- (8) how well bottom plugged


DRILLERS REMARKS:

CODED

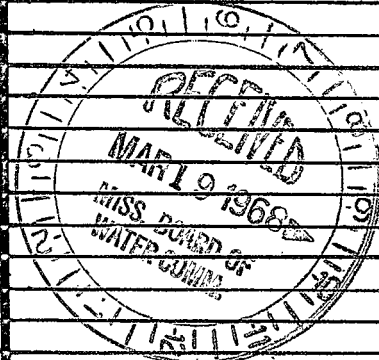

If well telescopes please sketch and show depths.

GROUND LEVEL

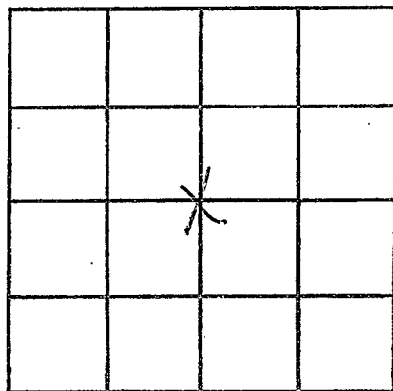

SECTION _____

Please indicate well location X.

ADDITIONAL INFORMATION

If more than one screen,
show locations of each on sketch.