

CODED

KONTOC

UNION

F 45

5-68

MISSISSIPPI
 BOARD OF WATER COMMISSIONERS
 416 North State Street
 Jackson, Mississippi 39201

WATER WELL DRILLERS LOG

5-26 1968 Clark Bros. Union
 date well completed firm name county well located

LANDOWNER: NICKY MOORE

Route 5

Pontotoc
(mailing address)

WELL LOCATION:

sec 20 T 9 S R 2 E
7 miles W of Pontotoc
 (distance) (direction) (nearest town)

WELL PURPOSE: Home
 (home, irrigation, municipal, industrial)

WELL COMPLETION DATA:

- (1) diameter (inches) 4"
- (2) total depth (feet) 396'
- (3) static water level (feet) 142' below top of ground.
- (4) casing Metal, 109'
(material) (depth)
4"
(size) If telescope see back.
- (5) screen None
(length) (depth to top)

(size) (material)
- (6) pump 1 1/2 inch 5
(HP) (yield gpm)
Electric
(type power)
- (7) electric log No
(yes or no)

(organization running log)
- (8) how well bottom plugged no

description of formations encountered

from to

<u>Red Red clay</u>	<u>0</u>	<u>20</u>
<u>Sand</u>	<u>20</u>	<u>60</u>
<u>Sand</u>	<u>60</u>	<u>100</u>
<u>Blue mud</u>	<u>102</u>	<u>280</u>
<u>Rock & Sand</u>	<u>280</u>	<u>350</u>
<u>Blue mud</u>	<u>350</u>	<u>370</u>
<u>Rock & Sand</u>	<u>370</u>	<u>396</u>


CODED

UNION-2-15-1968
 MISS. BOARD OF
 WATER COMMISSIONERS

DRILLERS REMARKS:

If well telescopes please sketch and show depths.

GROUND LEVEL

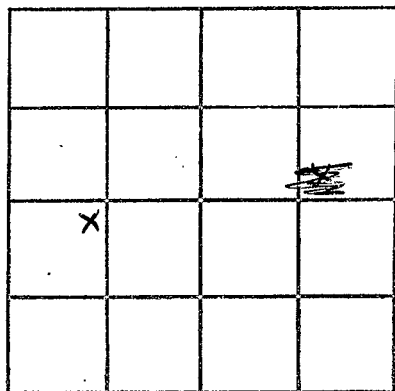

SECTION _____

Please indicate well location X.

ADDITIONAL INFORMATION

If more than one screen, show locations of each on sketch.