

PonToToC  
 F-49  
 8-18-71

MISSISSIPPI  
 BOARD OF WATER COMMISSIONERS  
 416 North State Street  
 Jackson, Mississippi 39201

WATER WELL DRILLERS LOG

**CODED**  
 Pontotoc

Aug 13 1971  
 date well completed

J. W. Welch & Sons  
 firm name

Pontotoc  
 county well located

LANDOWNER: James Wright

description of formations encountered

from to

Pontotoc Miss  
 (mailing address)

Soil	0	1
Bunks	1	35
Blue Rock	35	78.7
Water Rock	287	289
Water Sand & Rock	289	385
Ripley Sand		

WELL LOCATION:

sec. 8 T. 105 N. R. 2 E  
 S  
 1/2 miles West of Springville  
 (distance) (direction) (nearest town)

WELL PURPOSE:  
 (home, irrigation, municipal, industrial)

WELL COMPLETION DATA:

- (1) diameter (inches) 5"
- (2) total depth (feet) 385
- (3) static water level (feet) 127 below top of ground.
- (4) casing Steel, 4 1/2" (material), (depth)  
 5" (size) if telescope see back.
- (5) screen 0 (length), 0 (depth to top)  
 (size) (material)
- (6) pump 1 HP Sub 14 (HP) (yield gpm)  
 Elec (type power)
- (7) electric log no (yes or no)
- (organization running log)
- (8) how well bottom plugged

**CODED**


SEP 18 1971

DRILLERS REMARKS:

MISSISSIPPI  
 WATER COMMISSIONERS

If well telescopes please sketch and show depths.

GROUND LEVEL

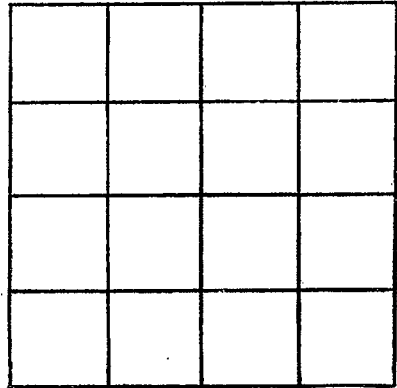

SECTION \_\_\_\_\_

Please indicate well location X.

ADDITIONAL INFORMATION

If more than one screen, show locations of each on sketch.