

F 50

2-12-65

WATER WELL DRILLERS LOG

CODED

Date: 2-12, 19 65, Driller: LAMAR WILBET County PONTOTOC

(Name)

(1) Owner of Land:	Description & Color of Materials Sand, Clay, Red Clay, Shell, etc.	Thick- ness Feet	Depth Feet
<u>LOONIE WILLIAMS</u> (Name)	<u>GREY ROCKSAND</u>	<u>22</u>	<u>22</u>
(Address)	REDACTED		
(2) Location: <u>1/4</u> , <u>1/4</u> , Sec. <u>32 T10 R 2</u>	<u>GREY LIMESTONE</u>	<u>48</u>	<u>70</u>
<u>9</u> miles <u>HWY 3112</u> of <u>PONTOTOC</u> (distance) (direction) (Nearest Town)	<u>BLUE SHALE</u>	<u>80</u>	<u>150</u>
(3) Topography: <u>FLAT WOODS</u> (Hilly) (Flat) (Level)	<u>WHITE ROCK SAND</u>	<u>28</u>	<u>404</u>
(4) Purpose of Well: <u>PRIVATE HOME</u> (Domestic Irrigation Municipal, Industrial, Other)			

Information upon completion of well:

(1) Diameter 4 inches.

(2) Total Depth 403 feet.

(3) Water Level 70 feet below top of ground.

(4) Cased to 84, Size 4"


(5) Screen: Size _____, Length _____

(6) Were any formations sealed against pollution?
_____ yes, _____ no.

If YES depth of formation _____

Why _____

Drillers Remarks: _____

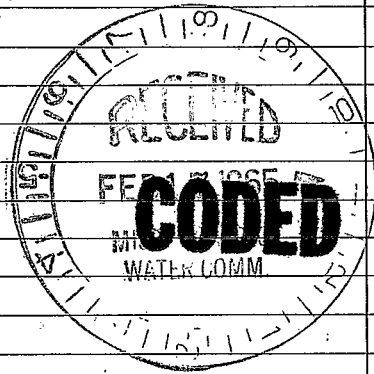

(Use Back Side)

Well No.

0000

0000