

**PONTOTOC**  
**F 51**  
**11-20-71**

MISSISSIPPI  
 BOARD OF WATER COMMISSIONERS  
 416 North State Street  
 Jackson, Mississippi 39201

WATER WELL DRILLERS LOG

11-20-1971 date well completed  
 Leepul Drilling Co firm name  
 Pontotoc county well located

LANDOWNER:

Pete Tutor

description of formations encountered

from to

Rt 5 - Pontotoc, Miss  
 (mailing address)

Red Clay + Rocks	0	40
Blue clay	40	84
Blue clay + chalk	84	250
Sand	250	335

WELL LOCATION:

sec. 5 T 10 S R 2 E  
 6 miles SW of Pontotoc  
 (distance) (direction) (nearest town)

WELL PURPOSE:

Home  
 (home, irrigation, municipal, industrial)

WELL COMPLETION DATA:

- (1) diameter (inches) 4
- (2) total depth (feet) 335
- (3) static water level (feet) 110 below top of ground.
- (4) casing steel, 84  
 (material) (depth)
- 4 if telescope see back.  
 (size)
- (5) screen open  
 (length) (depth to top)
- (size) (material)
- (6) pump 3/4 7  
 (HP) (yield gpm)
- Elect  
 (type power)
- (7) electric log no  
 (yes or no)

(organization running log)

(8) how well bottom plugged open


DRILLERS REMARKS:

JAN 10 1972

MISS. Bd. OF WATER COMM.

If well telescopes please sketch and show depths.

GROUND LEVEL

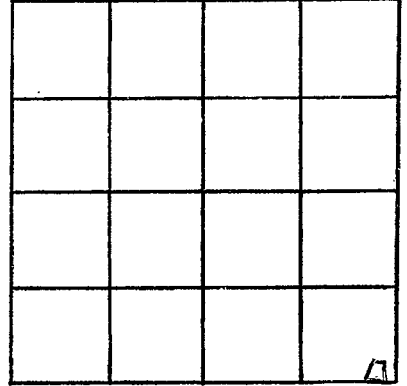

SECTION 5

Please indicate well location X.

ADDITIONAL INFORMATION

If more than one screen, show locations of each on sketch.