

PONTOTOC
F 52
6-10-72

MISSISSIPPI
 BOARD OF WATER COMMISSIONERS
 416 North State Street
 Jackson, Mississippi 39201

WATER WELL DRILLERS LOG

6-10-1972 *Leepel Drilling Co* *Pontotoc*
 date well completed firm name county well located


LANDOWNER:	description of formations encountered	from	to
<i>T. R. Lawson</i>	<i>Flinted limbs</i>	<i>0</i>	<i>60</i>
<i>Rt 1 - Randolph</i> (mailing address)	<i>Rock + Red Sand</i>	<i>60</i>	<i>80</i>
	<i>Blue Clay + Chalk</i>	<i>80</i>	<i>200</i>
	<i>Rock + Sand</i>	<i>200</i>	<i>335</i>
WELL LOCATION:			
sec <i>20</i> T <i>10</i> N R <i>20</i> <i>6</i> miles <i>S 41</i> of <i>Pontotoc</i> (distance) (direction) (nearest town)			
WELL PURPOSE: <i>Home</i> (home, irrigation, municipal, industrial)			
WELL COMPLETION DATA:			
(1) diameter (inches) <i>4</i>			
(2) total depth (feet) <i>335</i>			
(3) static water level (feet) <i>80</i> below above top of ground.			
(4) casing <i>steel</i> , <i>8 1/2'</i> (material) (depth)			
_____ if telescope see back. (size)			
(5) screen <i>none</i> (length) (depth to top)			
_____ (size) _____ (material)			
(6) pump <i>3/4</i> <i>7</i> (HP) (yield gpm)			
<i>Elect</i> (type power)			
(7) electric log <i>no</i> (yes or no)			
_____ (organization running log)			
(8) how well bottom plugged <i>open</i>			
DRILLERS REMARKS:			

JUL 12 1972

MISS
 WELLS

If well telescopes please sketch and show depths.

GROUND LEVEL

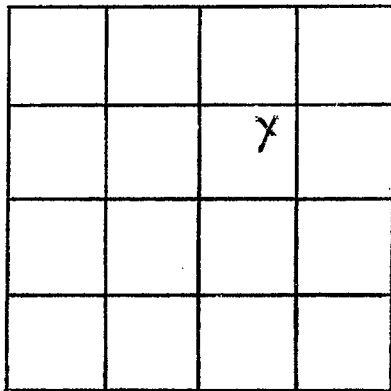

SECTION 20

Please indicate well location X.

ADDITIONAL INFORMATION

If more than one screen,
show locations of each on sketch.