

If well telescopes please sketch and show depths.

GROUND LEVEL


1309' →
Casing, 8" →

1380' ↑

9 cu. yds →
Arcola 10-20 →

80'
4" SS

If more than one screen/BWV show locations of each on sketch.

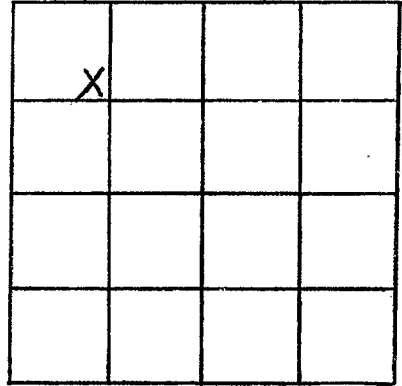

SECTION _____

Please indicate well location X.

ADDITIONAL INFORMATION

Static WL 285'

Pumping WL 390'

259 GPM