

MISSISSIPPI DEPARTMENT OF ENVIRONMENTAL QUALITY  
Office of Land and Water Resources

COUNTY WELL LOCATED  
**KENTON**

WELL NUMBER  
**F-6259**

CODED

DATE WELL COMPLETED  
**2-14-01**

PERMIT NUMBER  
**MS-GW-15526**

NAME OF DRILLING FIRM  
**PARKS + PARKS WELL SERVICE HOUSTON MS**

P. O. Box 10631  
Jackson, MS 39289-0631  
WATER WELL DRILLERS LOG

NAME & MAILING ADDRESS OF LANDOWNER  
**ALGOMA WATER ASSN.  
P.O. BOX 123  
ALGOMA, MS 38820**

WELL LOCATION SEC TOWNSHIP RANGE  
**9 10 S 2 E**

DISTANCE DIRECTION NEAREST TOWN  
**6 Miles WEST of ALGOMA**

OTHER LANDMARK

WELL PURPOSE Home, Irrigation, Municipal, Industrial, Fish Pond, etc  
 Municipal

PUMP DATA

PUMP TYPE (Circle One):  
Submersible,  Turbine, Jet, Flowing Well,  
Other (Describe)

POWER TYPE (Circle One):  
 Electric, Tractor, Diesel, Gasoline, Bulano,  
Other (Describe) H/P **45**

Pump Capacity (GPM) No. of Stages Setting Depth  
**400 11 540** FT.

PUMP TEST  
Well yielded **400** GPM with  
a drawdown of **147** ft.  
after **12** hours of pumping

WELL DATA

Well Depth <b>1340</b>	Casing Diameter (In.) <b>12</b>	Casing Length (Ft.) <b>1225</b>
Type of Casing <b>STEEL</b>	Hole Depth <b>1383</b>	Depth to Static Water Level <b>345</b>

TYPE OF COMPLETION: (Circle One or More):  
 Gravel Packed,  Underreamed,  Telescoped,  
 Natural Development,  Open Hole,  Other (Describe)

WELL GROUTED TO A DEPTH OF **1225** FEET  
Type Grout (circle one)  Cement,  Bentonite, or Mix

LOG DATA

TYPE OF LOG RUN (Circle One):  
 Electric,  Gamma Ray,  Density,  Sonic,  Neutron,  
Other (Describe)

Name of Organization Running Log  
**MSG-S**

SCREEN DATA

Diameter - Inches <b>8</b>	Length - Feet <b>115</b>	Slot Size - Inches <b>.016</b>
Screen Type <b>SS</b>	Depth to Bottom - feet <b>1340</b>	

GEOLOGIC DATA (Office Use Only)

Surface Elev.	Geologic Unit	Unit Thickness	Depth to Top
Subs. SWL	Date	Analysis	Aquifer Test


Driller's Remarks

Top of Lap Pipe or Reduction in Casing  
FEET IF TELESCOPED OR MORE THAN ONE SCREEN; USE BACK PAGE

DESCRIPTION OF FORMATIONS ENCOUNTERED	FROM	TO	FORMATIONS (Continued)	FROM	TO
TOP SOIL	0	10			
CLAY	10	50			
CLAY-SHALL	50	274			
CLAY-SAND	274	296			
CLAY	296	1196			
CLAY SAND	1196	1225			
SAND	1225	1383			

**EX COPY**  
**ORIGINAL**

If well telescopes please sketch and show depths.

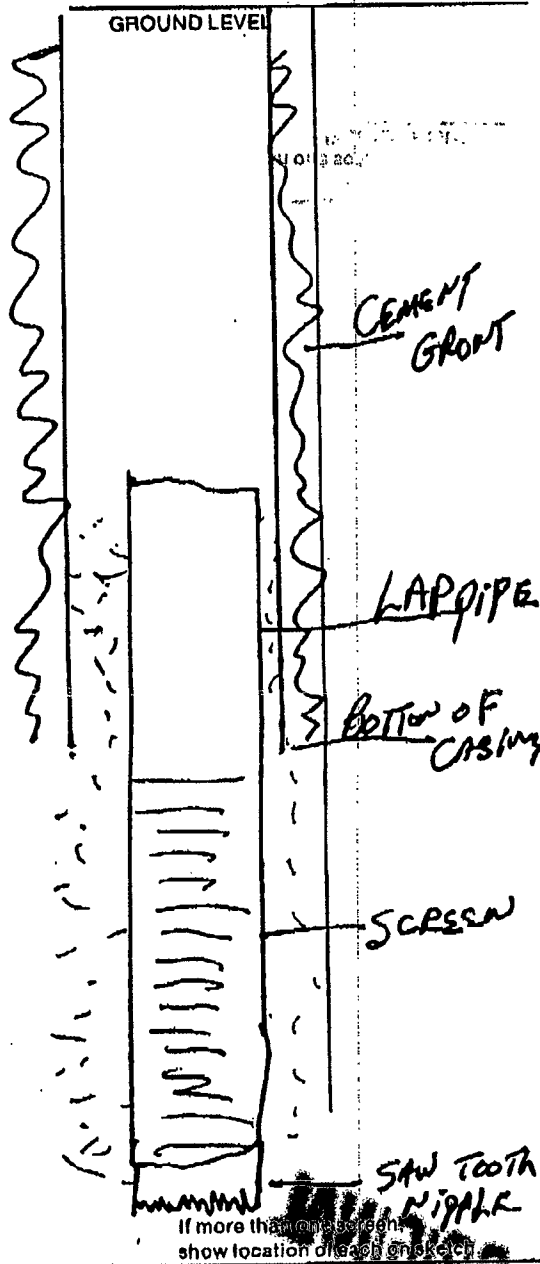


SECTION \_\_\_\_\_  
Please indicate well location X.

ADDITIONAL INFORMATION

---

---

If more than one screen, show location of each on sketch.