

MISSISSIPPI DEPARTMENT OF NATURAL RESOURCES

Bureau of Land and Water Resources

Southport Mall

P.O. Box 10631

Jackson, Mississippi 39209

WATER WELL DRILLERS LOG

Pontotoc
F
2001

Leeper Drilling Pontotoc

3-1- 1983
 date well completed

firm name

county well located

LANDOWNER: Cecil Moss
Rt 5 (Dan Moore Rd.)
Pontotoc MS
 (mailing address)

description of formations encountered	from	to
<u>Top Bumbo</u>	<u>0</u>	<u>20</u>
<u>Blue clay</u>	<u>20</u>	<u>120</u>
<u>Rock & sand</u>	<u>120</u>	<u>180</u>
<u>Coarse Sand</u>	<u>180</u>	<u>205</u>

WELL LOCATION:
 sec 24 T 10 N R 2 (E) W
4 miles SW of Algona
 (distance) (direction) (nearest town)

WELL PURPOSE: Home
 (home, irrigation, municipal, industrial)

- WELL COMPLETION DATA:
- (1) diameter (inches) 4"
 - (2) total depth (feet) 205
 - (3) static water level (feet) 80 below top of ground above
 - (4) casing PVC 120'
 (material) (depth)
4"
 (size) If telescope see back.
 - (5) screen None
 (length) (depth to top)
 (size) (material)
 - (6) pump 3/4 10
 (HP) (yield gpm)
electric
 (type power)
 - (7) electric log —
 (yes or no)
 (organization running log)
 - (8) how well bottom plugged OPEN

DRILLERS REMARKS:


DEPT. OF NATURAL RESOURCES
 BUREAU OF LAND & WATER RESOURCES

MAY 31 1987

RECEIVED

If well telescopes please sketch and show depths.

GROUND LEVEL

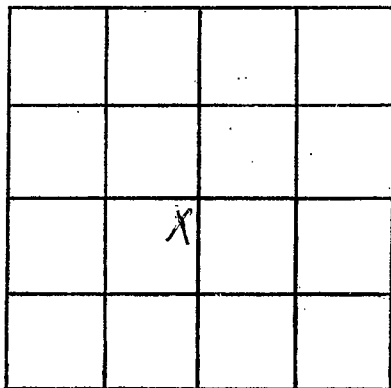

SECTION 34

Please indicate well location X.

ADDITIONAL INFORMATION

If more than one screen,
show locations of each on sketch.