

Pontotoc
G 31
11-3-69

MISSISSIPPI
 BOARD OF WATER COMMISSIONERS
 416 North State Street
 Jackson, Mississippi 39201

CODED

WATER WELL DRILLERS LOG

NOV 3 1969 J. W. Webb & Sons Pontotoc
 date well completed firm name county well located

LANDOWNER: Basley Hallaway

description of formations encountered	from	to
---------------------------------------	------	----

Pontotoc, Miss
 (mailing address)

Soil	0	17
Sand & Clay	17	121
Sand Rock	121	123
Blue sand & Scepter	123	165
Blue Rock	165	360
Dry Coffee sand	360	410
Blue Rock	410	490
Water Sand	490	940
(Water)		

WELL LOCATION:
 sec. 22 T. 10S N R. 3 E
 S W
4 1/2 miles South E of Pontotoc
 (distance) (direction) (nearest town)

WELL PURPOSE:
 (home, irrigation, municipal, industrial)

WELL COMPLETION DATA:

- (1) diameter (inches) 4
- (2) total depth (feet) 940
- (3) static water level (feet) 220 below top of ground.
- (4) casing 4 170
 (material) (depth)
4" if telescope see back.
 (size)
- (5) screen _____
 (length) (depth to top)

 (size) (material)
- (6) pump 3/4 HP Sub 8
 (HP) (yield gpm)
Elec.
 (type power)
- (7) electric log _____
 (yes or no)

 (organization running log)
- (8) how well bottom plugged _____


DEC - 8 1969

MISS. BD. OF
 WATER COMM.

DRILLERS REMARKS:

If well telescopes please sketch and show depths.

GROUND LEVEL

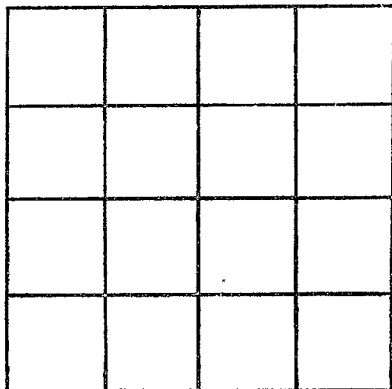

SECTION _____

Please indicate well location X.

ADDITIONAL INFORMATION

If more than one screen, show locations of each on sketch.