

CODED

MISSISSIPPI
BOARD OF WATER COMMISSIONERS
416 North State Street
Jackson, Mississippi 39201

WATER WELL DRILLERS LOG

Pontotoc
G32
12-30-69

12-30-1969 date well completed
Leeper Drilling firm name
Pontotoc county well located

LANDOWNER:

IUY SEWELL
R+1 PONTOTOC
(mailing address)

description of formations encountered

Red Clay 0 30
Red Sandy Clay & Rock 30 65
Blue clay & Rock 65 90
Rock & Blue Clay 90 150
Sand 150 189

from to

WELL LOCATION:

sec. 28 T. 10 S. R. 3 E
4 miles SW of Pontotoc
(distance) (direction) (nearest town)

WELL PURPOSE:

Home
(home, irrigation, municipal, industrial)

WELL COMPLETION DATA:

- (1) diameter (inches) 4"
- (2) total depth (feet) 189'
- (3) static water level (feet) 80 below top of ground.
- (4) casing steel, 126' (material) (depth)
4 (size) if telescope see back.
- (5) screen OPEN (length) (depth to top)
(size) (material)
- (6) pump 3/4 (HP) 6 (yield gpm)
Elect (type power)
- (7) electric log no (yes or no)

(organization running log)

(8) how well bottom plugged Open


DRILLERS REMARKS:

FEB 9 - 1970

MISS. BD. OF
WATER COMM.

If well telescopes please sketch and show depths.

GROUND LEVEL

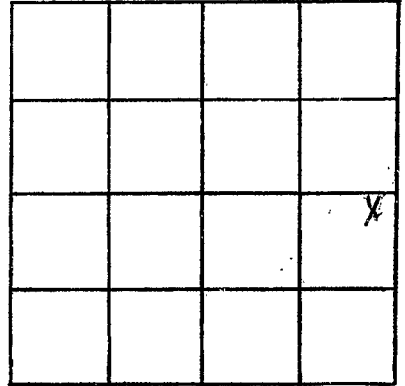

SECTION _____

Please indicate well location X.

ADDITIONAL INFORMATION

If more than one screen,
show locations of each on sketch.