

CODED

MISSISSIPPI
BOARD OF WATER COMMISSIONERS
416 North State Street
Jackson, Mississippi 39201

WATER WELL DRILLERS LOG

Pontotoc
G 33
1-20-70

1-20-70 date well completed
Leepul Drilling firm name
Pontotoc county well located

LANDOWNER:

Rassie Johnson
Rt 1- Pontotoc
(mailing address)

description of formations encountered

from to

Red Clay 0 25
Red Sandy clay & Rock 25 65
Blue Clay & Rock 65 100
Rock & Blue Clay 100 160
Sand 160 195

WELL LOCATION:

sec. 29 T. 10 S. R. 3 E
5 miles S of Pontotoc
(distance) (direction) (nearest town)

WELL PURPOSE:

Drainage
(home, irrigation, municipal, industrial)

WELL COMPLETION DATA:

- (1) diameter (inches) 4
- (2) total depth (feet) 195
- (3) static water level (feet) 85 below top of ground.
- (4) casing Steel 126 (material) (depth)
4 (size) if telescope see back.
- (5) screen None (length) (depth to top)
(size) (material)
- (6) pump 3/4 6 (HP) (yield gpm)
Elect (type power)
- (7) electric log no (yes or no)

(organization running log)

(8) how well bottom plugged open


DRILLERS REMARKS:

FEB 9 - 1970

MISS. BD. OF
WATER COMMISSIONERS

If well telescopes please sketch and show depths.

GROUND LEVEL

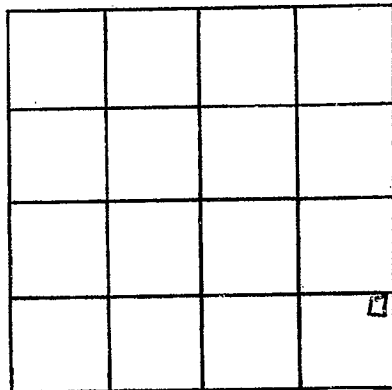

SECTION _____

Please indicate well location X.

ADDITIONAL INFORMATION

If more than one screen, show locations of each on sketch.