

Pontotoc
G 34
6-6-70

MISSISSIPPI
BOARD OF WATER COMMISSIONERS
416 North State Street
Jackson, Mississippi 39201

WATER WELL DRILLERS LOG **CODED**

6-6-70 date well completed 1970 Clark Bros. firm name Pontotoc county well located

LANDOWNER:

J. P. Stegall
Pontotoc St-1
(mailing address)

description of formations encountered

from to

3' mud	0	20
Rock & sand	20	60
Blue mud	60	70
Chalk clay	70	80
Rock & sand	80	990

WELL LOCATION:

sec. 27 T. 10 N. R. 3 E
6 miles SE of Pontotoc
(distance) (direction) (nearest town)

WELL PURPOSE:

Home
(home, irrigation, municipal, industrial)

WELL COMPLETION DATA:

- (1) diameter (inches) 4"
- (2) total depth (feet) 990'
- (3) static water level (feet) 310 below top of ground.
- (4) casing metal 90' (material) (depth)
4" (size) if telescope see back.
- (5) screen None (length) (depth to top)
- (6) pump Rod 4 (HP) (yield gpm)
Electric (type power)
- (7) electric log no (yes or no)
- (8) how well bottom plugged no

CODED


JUL 1 1970

DRILLERS REMARKS:

MISS. BD. OF
WATER COMMT

If well telescopes please sketch and show depths.

GROUND LEVEL

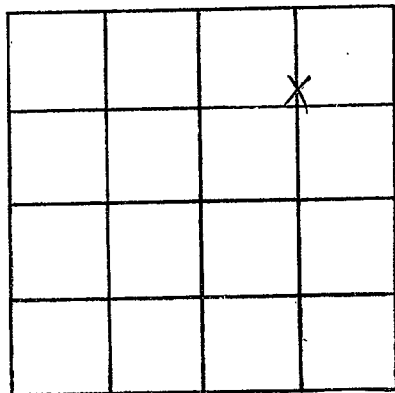

SECTION _____

Please indicate well location X.

ADDITIONAL INFORMATION

If more than one screen, show locations of each on sketch.