

PONTOTOC

# WATER WELL DRILLERS LOG

G-36  
2-20-62

Date: 2-20-62, 1962, Driller: J. J. [unclear] County: Pontotoc

**CODED**

(Name)

(1) Owner of Land: J. J. [unclear]  
(Name)

Pontotoc  
(Address)

(2) Location: 1/4 NW 1/4, Sec. 9 T10R26  
1 miles South of Pontotoc  
(distance) (direction) (Nearest Town)

(3) Topography: X  
(Hilly) (Flat) (Level)

(4) Purpose of Well: Domestic  
(Domestic Irrigation  
Municipal, Industrial, Other)

Description & Color of Materials Sand, Clay, Red Clay, Shell, etc.	Thick- ness Feet	Depth Feet
<u>Clay &amp; silt</u>	<u>20</u>	<u>20</u>
<u>Sand</u>	<u>25</u>	<u>45</u>
<u>Blue &amp; red</u>	<u>15</u>	<u>60</u>
<u>Blue &amp; red</u>	<u>15</u>	<u>75</u>
<u>sand</u>	<u>30</u>	<u>105</u>
<u>rock &amp; sand</u>	<u>15</u>	<u>120</u>

### Information upon completion of well:

(1) Diameter 4 1/2 inches.

(2) Total Depth 125 feet.

(3) Water Level 91 feet below top of ground.

(4) Cased to 63, Size 4 1/2

(5) Screen: Size \_\_\_\_\_, Length \_\_\_\_\_

(6) Were any formations sealed against pollution?  
X yes, \_\_\_\_\_ no.

If YES depth of formation \_\_\_\_\_


Why \_\_\_\_\_

Drillers Remarks: \_\_\_\_\_

\_\_\_\_\_

\_\_\_\_\_

**CODED**

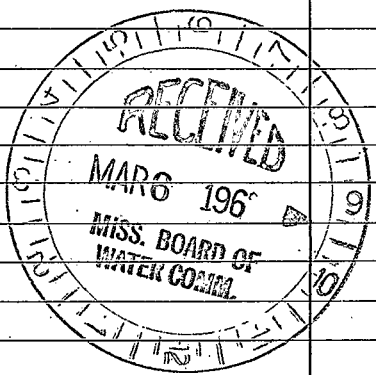

(Use Back Side)

Well No.

