

PONTOTOC
G-38
3-8-62

WATER WELL DRILLERS LOG

Date: 3-8, 1962, Driller: J L ... County: Pontotoc
(Name)

- (1) Owner of Land: CODED
Pontotoc A & H
(Address)
- (2) Location: 1/4 NW 1/4, Sec. 5 T. 18 N. R. 10 E.
1 1/2 miles South of Pontotoc
(distance) (direction) (Nearest Town)
- (3) Topography: X
(Hilly) (Flat) (Level)
- (4) Purpose of Well: Domestic
(Domestic Irrigation
Municipal, Industrial, Other)

Description & Color of Materials Sand, Clay, Red Clay, Shell, etc.	Thick- ness Feet	Depth Feet
<u>clay rock</u>	<u>15</u>	<u>15</u>
<u>sand</u>	<u>25</u>	<u>40</u>
<u>Blind gravel rock</u>	<u>15</u>	<u>105</u>
<u>rock & coal</u>	<u>60</u>	<u>165</u>


Information upon completion of well:

- (1) Diameter 4 inches.
- (2) Total Depth 165 feet.
- (3) Water Level 48 feet below top of ground.
- (4) Cased to 63, Size _____.
- (5) Screen: Size _____, Length _____.
- (6) Were any formations sealed against pollution?
_____ yes, _____ no.

If YES depth of formation _____
Why _____

Drillers Remarks: _____

CODED

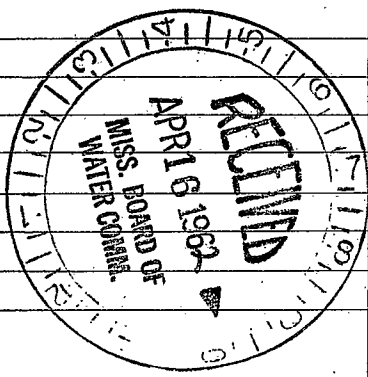

(Use Back Side)

Well No.

Handwritten notes, possibly a list or index, with some illegible text and a small 'X' mark.