

For to to

MISSISSIPPI BOARD OF WATER COMMISSIONERS

Lat 34-13-45

Long 89-00-18

MS # GW 618

ELSV

370'

G-40 10-66 G-47

WATER WELL DRILLERS LOG

CODED

Date: 10-15-, 1966, Driller: Layne-Central Co. County Pontotoc

CODED

(Name)

(1) Owner of Land: Town of Pontotoc
 (Name)
Pontotoc, Mississippi
 (Address)

(2) Location: 1/4, SW 1/4, Sec. 32, T-28R, S-36E
 (distance) _____ miles, of _____ (Nearest Town)

(3) Topography: _____
 (Hilly) (Flat) (Level)

(4) Purpose of Well: Municipal
 (Domestic Irrigation, Municipal, Industrial, Other)

Description & Color of Materials Sand, Clay, Red Clay, Shell, etc.	Thick-ness Feet	Depth Feet
Sandy clay	4	4
black clay	7	11
rock	7	18
sand	5	23
sand-rock stks.	9	32
rock	2	34
gravel, sand-rock stks.	39	73
clay & rock	12	85
lime rock	75	160
lime, hard & soft stks.	59	219
sandy clay-rock stks.	13	232
hard clay & rock stks.	33	265
hard clay	128	393
hard clay-rock stks.	182	575
soapstone hard	90	665
clay & hard stks.	33	698
hard clay & sandy stks	32	730
rock	2	732
hard clay-sandy stks	138	870
sandy shale-hard stks	30	900
hard shale	20	920
sandy shale	40	960
hard shale-sandy stks	50	1010
fine sand-shale	21	1031
hard shale-sandy stks	10	1041
sand & shale	56	1097
sand shale & rock stks	18	1115
lime rock	18	1135
h.p. sand	12	1145
h.p. sand-gravel	12	1157
sandy shale	1	1158

Information upon completion of well:

(1) Diameter 12 inches. *gpl*

(2) Total Depth 1198 feet.

(3) Water Level _____ feet below top of ground.

(4) Cased to 1132', Size 8"


(5) Screen: Size 8", Length 80'

(6) Were any formations sealed against pollution?
 yes, no.

If YES depth of formation 1132'
 Why _____ required

Drillers Remarks: well completed
over

CODED

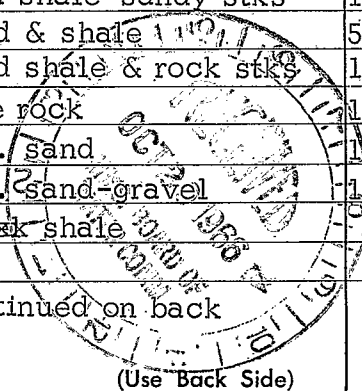

continued on back

(Use Back Side)

Well No.

⑧

A

sand	2	1160
hard shale-sand stks	12	1172
sand gravel & rock stks	20	1192
hard shale	2	1194
rock	2	1196
hard shale & rock	16	1212

of 10" 12 X 8
 Top screen

1097 Top screen
 B.S. - 1192 ⁵/₇₁₈
 20' screen
 15' blank
 60' screen
 96' B.P.

SWC 170' 10/11/66 75hp Tur.

320' of 8" X 2 1/2" X 1 1/2" Column
 10" bowl 10 stage
 PS 347' 8" ^{Gravel} G.W. all

From for [unclear] [unclear] [unclear]
 10/1/67